

MISSISSIPPI DEPARTMENT OF NATURAL RESOURCES

Bureau of Land and Water Resources

Southport Mall

P.O. Box 10631

Jackson, Mississippi 39209

WATER WELL DRILLERS LOG

Pearl River
U 2044

10/13 1981 Bud Penton Pearl River
date well completed firm name county well located

water well service

LANDOWNER: <u>Henny A</u>	description of formations encountered	from	to
<u>Carroll, onch</u> <u>Lake</u> (mailing address)		<u>Red shale</u>	<u>0</u>
	<u>White sand</u>	<u>40</u>	<u>60</u>
	<u>Black shale</u>	<u>60</u>	<u>300</u>
	<u>Gray sand</u>	<u>300</u>	<u>360</u>

WELL LOCATION:
 9 sec 3 T 5 N R 17 E W
3 miles East of Carroll
 (distance) (direction) (nearest town)

WELL PURPOSE: none
 (home, irrigation, municipal, industrial)


WELL COMPLETION DATA:

- (1) diameter (inches) 2 1/2
- (2) total depth (feet) 360
- (3) static water level (feet) 22 below above top of ground.
- (4) casing PVC 360
 (material) (depth)
- (size) If telescope see back.
- (5) screen 2x10 350
 (length) (depth to top)
- 12 PVC
 (size) (material)
- (6) pump 1/2 450
 (HP) (yield gpm)
- Electric
 (type power)
- (7) electric log no
 (yes or no)

(organization running log)


(8) how well bottom plugged plugged

DRILLERS REMARKS:

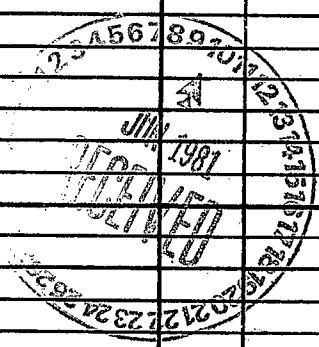

If well telescopes please sketch and show depths.

GROUND LEVEL

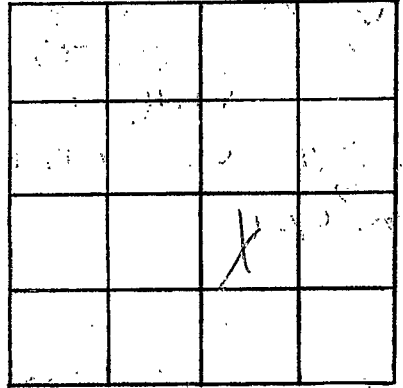

SECTION _____

Please indicate well location X.

ADDITIONAL INFORMATION

If more than one screen,
show locations of each on sketch.