

MISSISSIPPI DEPARTMENT OF NATURAL RESOURCES

Bureau of Land and Water Resources

Southport Mall

P.O. Box 10631

BUD PENTON & SON
WATER WELL SERVICE

Jackson, Mississippi 39209
WATER WELL DRILLERS LOG

CARRIERE, MS 39426
PHONE 798-5324

Pearl River
U 2047
9-10-81

9/10 1981 date well completed Pearl River firm name Pearl River county well located

LANDOWNER: <u>Fred Jennings</u>	description of formations encountered	from	to
(mailing address)			
<u>R 7-1 B 304 80A</u>	<u>Red Shale</u>	<u>0</u>	<u>60</u>
<u>poplarville miss.</u>	<u>Blue Shale</u>	<u>60</u>	<u>170</u>
	<u>Gray Sand</u>	<u>170</u>	<u>210</u>

WELL LOCATION:
sec. 23 T 5 N R 17 E
19 miles SW of Poplarville
(distance) (direction) (nearest town)

WELL PURPOSE: home
(home, irrigation, municipal, industrial)

WELL COMPLETION DATA:

(1) diameter (inches) 2"

(2) total depth (feet) 210

(3) static water level (feet) 60 below above top of ground.

(4) casing plc 210
(material) (depth)

_____ if telescope see back.
(size)

(5) screen 2x10 200
(length) (depth to top)

in plc
(size) (material)

(6) pump 1 450
(HP) (yield gal)

elect
(type power)

(7) electric log no
(yes or no)

_____ (organization running log)

(8) how well bottom plugged plugged
shock

DRILLERS REMARKS: _____


DEPT. OF NATURAL RESOURCES
BUREAU OF LAND & WATER RESOURCES

SEP 29 1981

RECEIVED

If well telescopes please sketch and show depths.

GROUND LEVEL

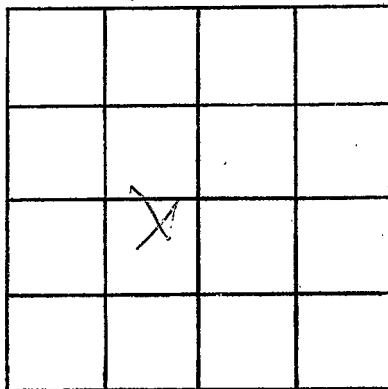

SECTION _____

Please indicate well location X.

ADDITIONAL INFORMATION

If more than one screen,
show locations of each on sketch.