

MISSISSIPPI DEPARTMENT OF NATURAL RESOURCES

Bureau of Land and Water Resources
 WATER WELL SERVICE
 ROUTE 3 BOX 41
 CARRIERE, MS 39426
 PHONE 798-5324
 Southport Mall
 P.O. Box 10631
 Jackson, Mississippi 39209

Pearl River
U 2048
8/26/81

ONE INCH WELL DRILLERS LOG
 WATER WELL SERVICE
 ROUTE 3 BOX 41
 CARRIERE, MS 39426
 PHONE 798-5324

8/26 1981
 date well completed

Pr
 county well located

LANDOWNER: John Ford

description of formations encountered

from to

Po Box 335

Red Shale
Blue Shale
Blue sand

0 20
20 275
275 311

Carriere Miss
 (mailing address)

WELL LOCATION:

sec. 22 T 5 N R. 17 E
62± miles W of Carriere
 (distance) (direction) (nearest town)

WELL PURPOSE: home
 (home, irrigation, municipal, industrial)

WELL COMPLETION DATA:

- (1) diameter (inches) 2 1/2
- (2) total depth (feet) 311
- (3) static water level (feet) 12 below above top of ground.
- (4) casing PVC 311
 (material) (depth)
 (size) if telescope see back.
- (5) screen 2x10 301
 (length) (depth to top)
12 PVC
 (size) (material)
- (6) pump 1 650
 (HP) (yield gpm)
Elect
 (type power)
- (7) electric log no
 (yes or no)

(organization running log)

(8) how well bottom plugged hard

DRILLERS REMARKS:


DEPT. OF NATURAL RESOURCES
 BUREAU OF LAND & WATER RESOURCES

SEP 29 1981

RECEIVED

If well telescopes please sketch and show depths.

GROUND LEVEL

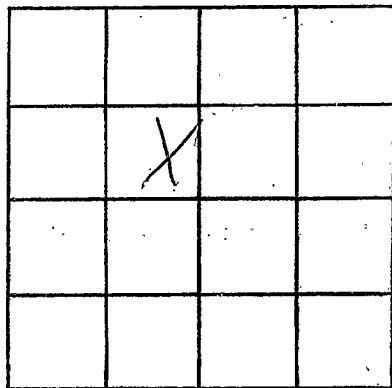

SECTION _____

Please indicate well location X.

ADDITIONAL INFORMATION

If more than one screen,
show locations of each on sketch.