

MISSISSIPPI DEPARTMENT OF NATURAL RESOURCES

Bureau of Land and Water Resources

Southport Mall

P.O. Box 10631

Jackson, Mississippi 39209

WALDEWEN & SONS LOG

WATER WELL SERVICE

ROUTE 3 BOX 41

CARRIERS, MS 39426

PHONE 798-5924

Pearl River
U.S.A.
5-28-81

5-28 1981
date well completed

Pearl River
county well located

LANDOWNER: *Edward H. Hargrave*
Carrriere Ms.

description of formations encountered

from

to

Red Shale
Red Soil

6 20
70 75

(mailing address)

WELL LOCATION:

sec *36* T *5* N R *17* E
S W
1 miles *W* of *Ozma*
(distance) (direction) (nearest town)

WELL PURPOSE: *Home*
(home, irrigation, municipal, industrial)

WELL COMPLETION DATA:

- (1) diameter (inches) *2"*
- (2) total depth (feet) *75'*
- (3) static water level (feet) *19'* below above top of ground.
- (4) casing *PVC* *1.5'*
(material) (depth)

if telescope see back.
(size)

- (5) screen *10'* *1.5'*
(length) (depth to top)

2" *PVC*
(size) (material)

- (6) pump *1* *800*
(HP) (yield gpm)

elba
(type power)

- (7) electric log _____
(yes or no)

(organization running log)

- (8) how well bottom plugged *And*
Shub

DRILLERS REMARKS: _____


DEPT. OF NATURAL RESOURCES
BUREAU OF LAND & WATER RESOURCES

NOV 9 1981

RECEIVED

If well telescopes please sketch and show depths.

GROUND LEVEL

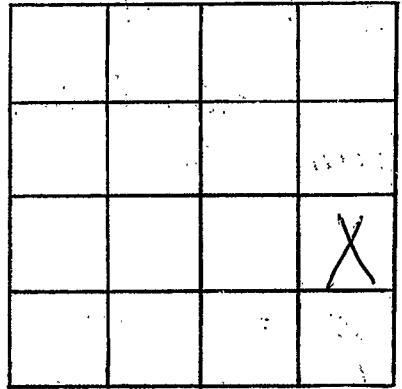

SECTION _____

Please indicate well location X.

ADDITIONAL INFORMATION

If more than one screen,
show locations of each on sketch.