

MISSISSIPPI DEPARTMENT OF NATURAL RESOURCES

Bureau of Land and Water Resources

Southport Mall

P.O. Box 10631

Jackson, Mississippi 39209

WATER WELL DRILLERS LOG

Pearl River  
 U 2053  
 10-4-81

10-4 1981 Bud Pentecost PR  
 date well completed firm name county well located

LANDOWNER: Calvin Lake  
Rock Ranch Rd.  
Covine Ms.  
 (mailing address)

description of formations encountered	from	to
gray shale	0	20
yellow sand	20	40
Blue shale	216	220
Blue sand	220	340

WELL LOCATION:  
 sec. 8 T. 8 N. R. 12 E.  
63± miles W of Covine  
 (distance) (direction) (nearest town)

WELL PURPOSE: None  
 (home, irrigation, municipal, industrial)

WELL COMPLETION DATA:

(1) diameter (inches) 4x2

(2) total depth (feet) 340

(3) static water level (feet) 50 below/above top of ground.

(4) casing PVC 330  
 (material) (depth)

if telescope see back.  
 (size)

(5) screen 10 330  
 (length) (depth to top)

2 PVC  
 (size) (material)

(6) pump 1/2 1800  
 (HP) (yield gpm)

elec  
 (type power)

(7) electric log \_\_\_\_\_  
 (yes or no)

(organization running log)

(8) how well bottom plugged good

DRILLERS REMARKS:


DEPT. OF NATURAL RESOURCES  
 BUREAU OF LAND & WATER RESOURCES

NOV 9 - 1981

RECEIVED

If well telescopes please sketch and show depths.

GROUND LEVEL

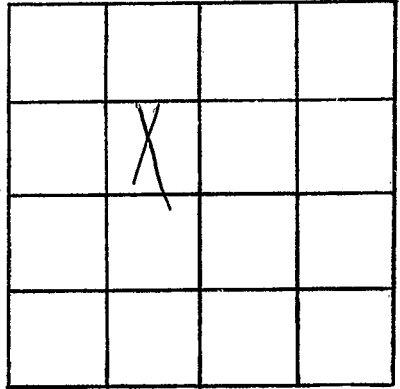

SECTION \_\_\_\_\_

Please indicate well location X.

ADDITIONAL INFORMATION

If more than one screen,  
show locations of each on sketch.

