

MISSISSIPPI DEPARTMENT OF NATURAL RESOURCES

Bureau of Land and Water Resources

Southport Mall

P.O. Box 10631

Jackson, Mississippi 39209

WATER WELL DRILLERS LOG

POUNCEY WATER WELL DRILLING

Pearl River
U 2254

Pearl River

1-26 1982
date well completed

firm name

county well located

LANDOWNER: Leonard Rood-

description of formations encountered

from

to

Rock Ranch Rd-

Top -

0 14

(mailing address)

sd

14 30

WELL LOCATION:

sec. 10 T. 5 N. R. 17 E.
6 miles W of Picayune
(distance) (direction) (nearest town)

sd: gravel -

30 48

sd Bottom Bottom

48 90

WELL PURPOSE: Home
(home, irrigation, municipal, industrial)

WELL COMPLETION DATA:

- (1) diameter (inches) 2
- (2) total depth (feet) 90
- (3) static water level (feet) 22 below top of ground.
- (4) casing PVC 80
(material) (depth)
- 2 if telescope see back.
(size)
- (5) screen 10 80
(length) (depth to top)
- 2 PVC
(size) (material)
- (6) pump 1 10
(HP) (yield gpm)
- AC
(type power)
- (7) electric log
(yes or no)
- (organization running log)
- (8) how well bottom plugged Sealed

DRILLERS REMARKS:


DEPT. OF NATURAL RESOURCES
BUREAU OF LAND & WATER RESOURCES

MAR - 3 1982

RECEIVED

If well telescopes please sketch and show depths.

GROUND LEVEL

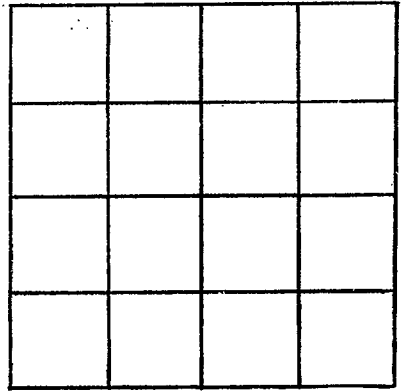

SECTION _____

Please indicate well location X.

ADDITIONAL INFORMATION

If more than one screen, show locations of each on sketch.