

MISSISSIPPI DEPARTMENT OF NATURAL RESOURCES

Bureau of Land and Water Resources

Southport Mall

P.O. Box 10631

Jackson, Mississippi 39209

WATER WELL DRILLERS LOG

Paul Rivers
BU
2055

Feb 18 1992 Walker Welding Paul Rivers
 date well completed firm name county well located

LANDOWNERS: Jessal Bahl
Carmine Miss
 (mailing address)

| description of formations encountered | from | to |
|---------------------------------------|-----------|-----------|
| <u>Red as shale</u> | <u>0</u> | <u>19</u> |
| <u>second fine</u> | <u>19</u> | <u>30</u> |
| <u>Coarse sandstone</u> | <u>30</u> | <u>42</u> |

WELL LOCATION:
 sec 8 T 5 N R 12 E
12 miles NE of Chicago
 (distance) (direction) (nearest town)

WELL PURPOSE: Home
 (home, irrigation, municipal, industrial)


- WELL COMPLETION DATA:
- (1) diameter (inches) 2'
 - (2) total depth (feet) 42'
 - (3) static water level (feet) 27 below above top of ground.
 - (4) casing PVC, 32
 (material) (depth)
 (size) if telescope see back.
 - (5) screen 10', 32
 (length) (depth to top)
12, PVC slat
 (size) (material)
 - (6) pump 1/2, 5
 (HP) (yield gpm)
Electric
 (type power)
 - (7) electric log (yes or no) _____
 (organization running log) _____
 - (8) how well bottom plugged solid
sharp

DRILLERS REMARKS: _____

DEPT. OF NATURAL RESOURCES
 BUREAU OF LAND & WATER RESOURCES
 FEB 24 1992
 RECEIVED

If well telescopes please sketch and show depths.

GROUND LEVEL

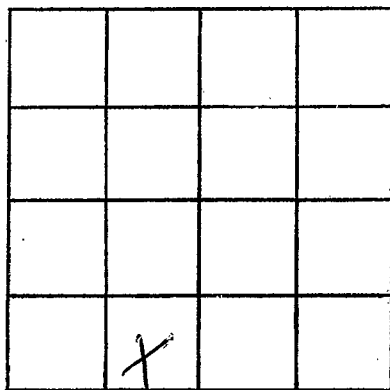

SECTION _____

Please indicate well location X.

ADDITIONAL INFORMATION

If more than one screen, show locations of each on sketch.