

MISSISSIPPI DEPARTMENT OF NATURAL RESOURCES

Bureau of Land and Water Resources

Southport Mall
 P.O. Box 10631
 Jackson, Mississippi 39209
 PHONE 798-5324

BOD PENTON & SON
 WATER WELL SERVICE
 ROUTE 4 BOX 402
 CARRIERE, MS 39426
 PHONE 798-5324

WATER WELL DRILLERS LOG

WATER WELL SERVICE
 WATER WELL SERVICE
 ROUTE 4 BOX 402
 CARRIERE, MS 39426
 PHONE 798-5324

Pearl River
U 2936

3/22 1983
 date well completed

Pearl River
 county well located

LANDOWNER: Don Limer
B-T-4 carrier
Miss.
 (mailing address)

description of formations encountered	from	to
<u>Red shale</u>	<u>0</u>	<u>30</u>
<u>Red sand</u>	<u>30</u>	<u>58</u>
<u>Blue shale</u>	<u>58</u>	<u>221</u>
<u>Blue sand</u>	<u>221</u>	<u>278</u>
<u>Blue shale</u>	<u>278</u>	<u>480</u>
<u>Gray sand</u>	<u>480</u>	<u>527</u>

WELL LOCATION:
 sec. 9 T. 5 N. R. 17 E.
S W
4" miles West of Carrier
 (distance) (direction) (nearest town)

WELL PURPOSE: home
 (home, irrigation, municipal, industrial)

- WELL COMPLETION DATA:
- (1) diameter (inches) 2"
 - (2) total depth (feet) 527
 - (3) static water level (feet) 45 below above top of ground.
 - (4) casing PVC, 527,
 (material) (depth)
 (size) if telescope see back.
 - (5) screen 2x6, 513
 (length) (depth to top)
1/2, PVC
 (size) (material)
 - (6) pump 1/2, 850
 (HP) (yield gpm)
Elect.
 (type power)
 - (7) electric log no
 (yes or no)

(organization running log)
 (8) how well bottom plugged dark
shark

DRILLERS REMARKS:


DEPT. OF NATURAL RESOURCES
 BUREAU OF LAND & WATER RESOURCES

APR 27 1983

RECEIVED

If well telescopes please
sketch and show depths.

GROUND LEVEL

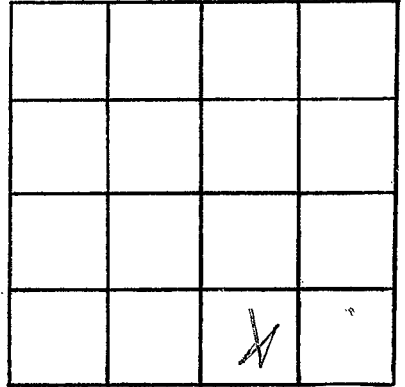

SECTION _____

Please indicate well location X.

ADDITIONAL INFORMATION

If more than one screen,
show locations of each on sketch.