

MISSISSIPPI DEPARTMENT OF NATURAL RESOURCES

Bureau of Land and Water Resources

Southport Mall

P.O. Box 10631

Jackson, Mississippi 39209

WATER WELL DRILLERS LOG

Pearl River
U.S.S.

6-17-83

19 Walker Welding

Pearl River

date well completed

firm name

county well located

LANDOWNER:

Hayward Smith

Rt. 2 Picayune Ms.

(mailing address)

description of formations encountered

from

to

Red and Gray Shale

0

19

Sand and Gravel

19

10

WELL LOCATION:

sec. 36 T. 5 N. R. 17 E. S. W.

5 miles West of Picayune
(distance) (direction) (nearest town)

WELL PURPOSE: Heat Pump Return
(home, irrigation, municipal, industrial)

WELL COMPLETION DATA:

- (1) diameter (inches) 2¹¹¹
- (2) total depth (feet) 10¹
- (3) static water level (feet) 19 below above top of ground.

(4) casing 2¹¹¹ PVC, 30¹
(material) (depth)

(size) If telescope see back.

(5) screen 10¹, 30¹
(length) (depth to top)

15, PVC
(size) (material)

(6) pump (HP) (yield gpm)

(type power)

(7) electric log (yes or no)

(organization running log)

(8) how well bottom plugged
Sand Shark


DRILLERS REMARKS:

DEPT. OF NATURAL RESOURCES
BUREAU OF LAND & WATER RESOURCES

JUL 7 1983
RECEIVED

If well telescopes please sketch and show depths.

GROUND LEVEL

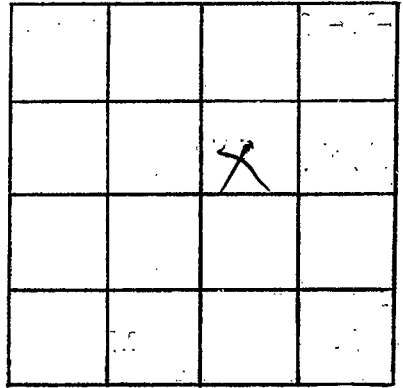

SECTION _____

Please indicate well location X.

ADDITIONAL INFORMATION

If more than one screen,
show locations of each on sketch.