

Pearl River
U2200

MISSISSIPPI DEPARTMENT OF NATURAL RESOURCES
Bureau of Land and Water Resources
Southport Mall
P.O. Box 10631
Jackson, Mississippi 39209
WATER WELL DRILLERS LOG

7-18-83 19
date well completed

Walker Welding
firm name

Pearl River
county well located

LANDOWNER:	description of formations encountered	from	to
Steven Poole Picayune, Ms. (mailing address)			
	Fine Sand	15	30
	Coarse Sand	30	48
WELL LOCATION:			
sec. <u>31</u> T. <u>5</u> N. R. <u>17</u> E S. W.			
<u>5</u> miles <u>North</u> of <u>Picayune</u> (distance) (direction) (nearest town)			
WELL PURPOSE: <u>Home</u> (home, irrigation, municipal, industrial)			
WELL COMPLETION DATA:			
(1) diameter (inches) <u>2</u>			
(2) total depth (feet) <u>48</u>			
(3) static water level (feet) <u>15</u> <u>below</u> top of ground. <u>above</u>			
(4) casing <u>PVC</u> , <u>38</u> (material) (depth) (size) If telescope see back.			
(5) screen <u>10</u> , <u>38</u> (length) (depth to top) <u>12</u> , <u>PVC</u> (size) (material)			
(6) pump <u>1/2</u> , <u>12</u> (HP) (yield gpm)			
<u>Electric</u> (type power)			
(7) electric log <u>no</u> (yes or no) (organization running log)			
(8) how well bottom plugged <u>Sand Shark</u>			

DEPT. OF NATURAL RESOURCES
BUREAU OF LAND & WATER RESOURCES


AUG 8 1983

RECEIVED

DRILLERS REMARKS:

If well telescopes please sketch and show depths.

GROUND LEVEL

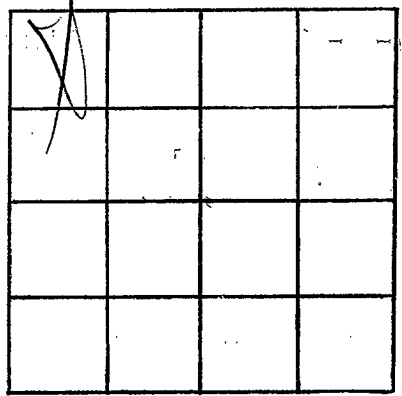

SECTION _____

Please indicate well location X.

ADDITIONAL INFORMATION

If more than one screen,
show locations of each on sketch.