

Pearl River  
W 2006

MISSISSIPPI  
BOARD OF WATER COMMISSIONERS  
416 North State Street  
Jackson, Mississippi 39201

WATER WELL DRILLERS LOG

5-2  
date well completed

1984 Penton Well Service  
firm name

Pearl River  
county well located

LANDOWNER: <u>Rick Flinn</u>	description of formations encountered	from	to
<u>Rt 1</u>			
<u>Carriere MS</u> (mailing address)	<u>surface clay</u>	<u>0</u>	<u>20</u>
	<u>sand</u>	<u>20</u>	<u>70</u>
	<u>clay</u>	<u>70</u>	<u>460</u>
	<u>sand</u>	<u>460</u>	<u>535</u>
WELL LOCATION: sec. <u>7</u> T. <u>5</u> S. R. <u>17</u> E S W			
<u>7</u> miles <u>N.W.</u> of <u>Prezyure</u> (distance) (direction) (nearest town)			
WELL PURPOSE: <u>Home</u> (home, irrigation, municipal, industrial)			
WELL COMPLETION DATA:			
(1) diameter (inches) <u>2</u>			
(2) total depth (feet) <u>535</u>			
(3) static water level (feet) <u>50</u> below top of ground. above			
(4) casing <u>PVC</u> , <u>525</u> (material) (depth)			
<u>2</u> (size) if telescope see back.			
(5) screen <u>10'</u> , <u>525</u> (length) (depth to top)			
<u>2</u> , <u>PVC</u> (size) (material)			
(6) pump <u>1/2</u> , <u>15</u> (HP) (yield gpm)			
<u>Elec</u> (type power)			
(7) electric log <u>NO</u> (yes or no)			
(organization running log)			
(8) how well bottom plugged <u>B.W. Valve</u>			

DEPT. OF NATURAL RESOURCES  
BUREAU OF LAND & WATER RESOURCES


MAY 30 1984

RECEIVED

DRILLERS REMARKS:  
1-HP Pump

If well telescopes please sketch and show depths.

GROUND LEVEL

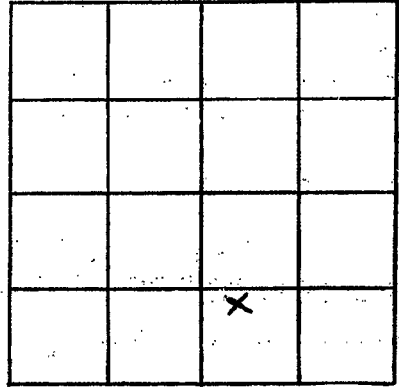

SECTION 7

Please indicate well location X.

ADDITIONAL INFORMATION

If more than one screen, show locations of each on sketch.