

MISSISSIPPI DEPARTMENT OF NATURAL RESOURCES

Bureau of Land and Water Resources

Southport Mall

P.O. Box 10631

Jackson, Mississippi 39209

WATER WELL DRILLERS LOG

Pearl River  
Wadsworth

2-14-84  
date well completed

19 POUNCEY WATER WELL DRILLING  
firm name

Pearl River  
county well located

LANDOWNER: Wilmer  
Wenningham  
Hyll North  
(mailing address)

WELL LOCATION:  
sec. 5 T. 5 N. R. 17 E.  
0 miles (distance) of Richardson (direction) of (nearest town)

WELL PURPOSE: Home  
(home, irrigation, municipal, industrial)

WELL COMPLETION DATA:

(1) diameter (inches) 2

(2) total depth (feet) 306

(3) static water level (feet) 43 below top of ground

(4) casing PC 294  
(material) (depth)  
2 (size) if telescope see back.

(5) screen 10 294  
(length) (depth to top)  
2 (size) PC (material)

(6) pump 1 10  
(HP) (yield gpm)  
AC (type power)

(7) electric log /  
(yes or no)  
(organization running log)

(8) how well bottom plugged /

description of formations encountered	from	to
<u>Top</u>	<u>0</u>	<u>20</u>
<u>SD Good Shallow</u>	<u>20</u>	<u>56</u>
<u>sd silt - pink</u>	<u>56</u>	<u>92</u>
<u>Clay Bage</u>	<u>92</u>	<u>130</u>
<u>Blue wt silt. mty</u>	<u>130</u>	<u>192</u>
<u>Blue Strucy</u>	<u>192</u>	<u>264</u>
<u>Blue sd</u>	<u>264</u>	<u>278</u>
<u>sily</u>	<u>278</u>	<u>283</u>
<u>sd top - ground</u>	<u>283</u>	<u>306</u>

DEPT. OF NATURAL RESOURCES  
BUREAU OF LAND & WATER RESOURCES


APR 12 1984

RECEIVED

DRILLERS REMARKS: /

If well telescopes please  
sketch and show depths.

GROUND LEVEL

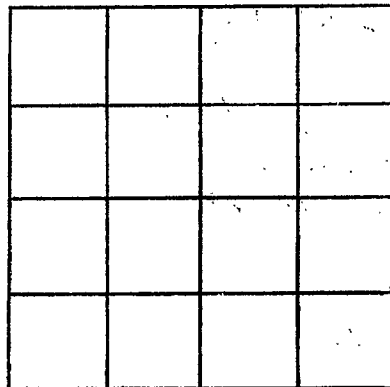

SECTION \_\_\_\_\_

Please indicate well location X.

ADDITIONAL INFORMATION

If more than one screen,  
show locations of each on sketch.