

MISSISSIPPI DEPARTMENT OF NATURAL RESOURCES

Bureau of Land and Water Resources

Southport Mall

P.O. Box 10631

Jackson, Mississippi 39209

WATER WELL DRILLERS LOG

Pearl River
U 200A

May 15 1984 Walker Welding Pearl River
date well completed firm name county well located


LANDOWNER: <u>John Fales</u> <u>Timber Son Estates</u> <u>Picayune Miss</u> (mailing address)	description of formations encountered	from	to
	<u>gray clay</u>	<u>0</u>	<u>18</u>
	<u>Sand</u>	<u>18</u>	<u>25</u>
	<u>Blue Clay</u>	<u>25</u>	<u>28</u>
	<u>Sand</u>	<u>28</u>	<u>57</u>
WELL LOCATION:			
sec <u>33</u> T <u>5</u> S R <u>17</u> E W.			
<u>2</u> miles <u>W</u> <u>Picayune</u> (distance) (direction) (nearest town)			
WELL PURPOSE: <u>Home</u> (home, irrigation, municipal, industrial)			
WELL COMPLETION DATA:			
(1) diameter (inches) <u>2"</u>			
(2) total depth (feet) <u>57'</u>			
(3) static water level (feet) <u>22'</u> <u>below</u> top of ground.			
(4) casing <u>2"</u> <u>47'</u> (material) (depth)			
_____ If telescope see back. (size)			
(5) screen <u>10</u> <u>47'</u> (length) (depth to top)			
<u>10</u> <u>PVC</u> (size) (material)			
(6) pump <u>1</u> <u>16</u> (HP) (yield gpm)			
<u>Elec</u> (type power)			
(7) electric log _____ (yes or no)			
_____ (organization running log)			
(8) how well bottom plugged <u>S.S.</u>			
DRILLERS REMARKS:			

DEPT. OF NATURAL RESOURCES
BUREAU OF LAND & WATER RESOURCES

JUN 18 1984
RECEIVED

If well telescopes please sketch and show depths.

GROUND LEVEL

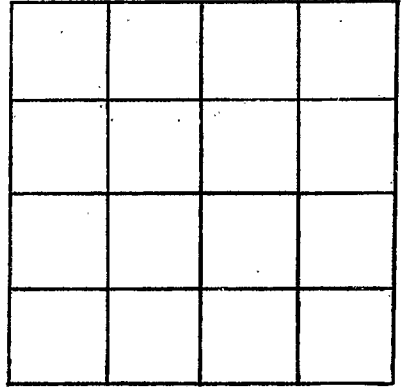

SECTION _____

Please indicate well location X.

ADDITIONAL INFORMATION

If more than one screen, show locations of each on sketch.