

MISSISSIPPI DEPARTMENT OF NATURAL RESOURCES

Bureau of Land and Water Resources

Southport Mall

P.O. Box 10631

Jackson, Mississippi 39209

WATER WELL DRILLERS LOG

WATER WELL SERVICE

ROUTE BOX

JACKSON, MISSISSIPPI 39204

Paul Rives  
U 2073

7/3 1984  
date well completed

Pearl River  
county well located

LANDOWNER: Stellie Smith

description of formations encountered

from to

R.T. 2 carriers

white shale

0 15

ms ss

white sand

15 60

(mailing address)

blue shale

60 285

gray sand

285 315

WELL LOCATION:

sec. 21 T 5 N R 17 E  
S W

6 miles W of Picayune  
(distance) (direction) (nearest town)

WELL PURPOSE: home  
(home, irrigation, municipal, industrial)

WELL COMPLETION DATA:

(1) diameter (inches) 2"

(2) total depth (feet) 315

(3) static water level (feet) 21 below above  
top of ground.

(4) casing PVC, 315,  
(material) (depth)

\_\_\_\_\_ If telescope see back.  
(size)

(5) screen 10 ft., 305  
(length) (depth to top)

10, PVC  
(size) (material)

(6) pump 1/2, 5-40  
(HP) (yield gpm)

Elect  
(type power) JAK

(7) electric log no  
(yes or no)

\_\_\_\_\_ (organization running log)

(8) how well bottom plugged shark


DRILLERS REMARKS:

DEPT. OF NATURAL RESOURCES  
BUREAU OF LAND & WATER RESOURCES

DEC - 4 1984  
RECEIVED

If well telescopes please sketch and show depths.

GROUND LEVEL

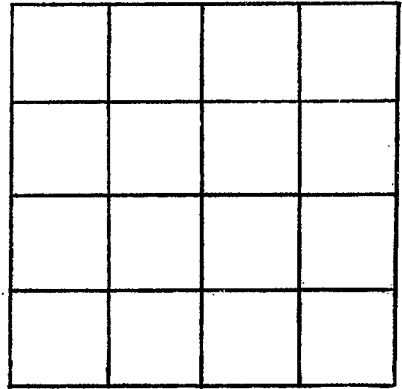

SECTION \_\_\_\_\_

Please indicate well location X.

ADDITIONAL INFORMATION

If more than one screen,  
show locations of each on sketch.