

MISSISSIPPI DEPARTMENT OF NATURAL RESOURCES

Bureau of Land and Water Resources

Southport Mall

P.O. Box 10631

Jackson, Mississippi 39209

WATER WELL DRILLERS LOG

PEARL RIVER  
 42074

6-12 1985 WALKERS WELDING PR  
 date well completed firm name county well located

LANDOWNER: <u>JAMES WILLIAMS</u>	description of formations encountered	from	to
<u>CARRIERE, MS.</u> (mailing address)	<u>CLAY</u>	<u>0</u>	<u>15</u>
	<u>SAND</u>	<u>15</u>	<u>28</u>
	<u>CLAY</u>	<u>28</u>	<u>304</u>
	<u>SAND</u>	<u>304</u>	<u>340</u>
WELL LOCATION: sec. <u>34 T 5 S</u> R. <u>17 W</u> <u>5</u> miles <u>SW</u> of <u>CARRIERE</u> (distance) (direction) (nearest town)			
WELL PURPOSE: <u>HOME</u> (home, irrigation, municipal, industrial)			
WELL COMPLETION DATA:			
(1) diameter (inches) <u>2"</u>			
(2) total depth (feet) <u>340</u>			
(3) static water level (feet) <u>26</u> below above top of ground.			
(4) casing <u>PVC</u> <u>340</u> (material) (depth)  (size) If telescope see back.			
(5) screen <u>15"</u> <u>325</u> (length) (depth to top)			
<u>2"</u> <u>PVC</u> (size) (material)			
(6) pump <u>NONE</u> (HP) (yield gpm)			
(type power)			
(7) electric log _____ (yes or no)			
(organization running log)			
(8) how well bottom plugged <u>Sand Shuck</u>			
DRILLERS REMARKS:			


RECEIVED

JUN 25 1985

Department of Natural Resources  
 Bureau of Land & Water Resources

If well telescopes please sketch and show depths.

GROUND LEVEL

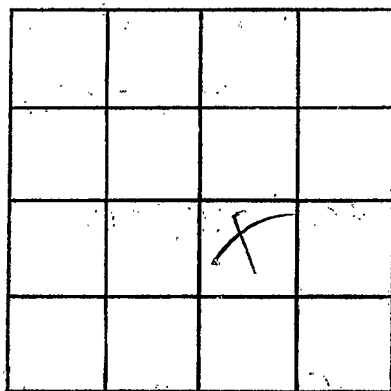

SECTION \_\_\_\_\_

Please indicate well location X.

ADDITIONAL INFORMATION

If more than one screen,  
show locations of each on sketch.