

MISSISSIPPI DEPARTMENT OF NATURAL RESOURCES

Bureau of Land and Water Resources

Southport Mall

P.O. Box 10631

Jackson, Mississippi 39209

WATER WELL DRILLERS LOG

PEAR RIVER
U 2075

6-11-1985 date well completed WALKERS WELDING firm name PR county well located

LANDOWNER: <u>WALTER B. WATHERS, JR.</u>	Description of formations encountered	from	to
<u>Picoyone Miss.</u> (mailing address)	<u>CLAY</u> <u>Sand</u>	<u>0</u>	<u>12</u> <u>90</u>
WELL LOCATION:			
sec. <u>21</u> T. <u>5</u> S. R. <u>17</u> W.			
<u>6</u> miles <u>N</u> of <u>Picoyone</u> (distance) (direction) (nearest town)			
WELL PURPOSE: <u>Drinking</u> (home, irrigation, municipal, industrial)			
WELL COMPLETION DATA:			
(1) diameter (inches) <u>2</u>			
(2) total depth (feet) <u>270</u>			
(3) static water level (feet) <u>12</u> below above top of ground.			
(4) casing <u>Pvc</u> / <u>40</u> (material) (depth)			
_____ (size) If telescope see back.			
(5) screen <u>10</u> / <u>30</u> (length) (depth to top)			
<u>2"</u> / <u>PVC</u> (size) (material)			
(6) pump <u>NONE</u> (HP) (yield gpm)			
_____ (type power)			
(7) electric log _____ (yes or no)			
_____ (organization running log)			
(8) how well bottom plugged <u>Sand Slack</u>			
DRILLERS REMARKS:			


RECEIVED

JUN 25 1985

Department of Natural Resources
Bureau of Land & Water Resources

If well telescopes please sketch and show depths.

GROUND LEVEL

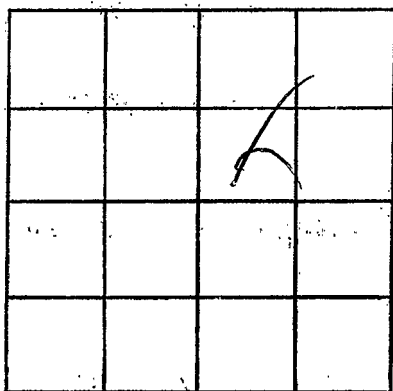

SECTION _____

Please indicate well location X.

ADDITIONAL INFORMATION

If more than one screen,
show locations of each on sketch.