

MISSISSIPPI DEPARTMENT OF NATURAL RESOURCES

Bureau of Land and Water Resources

Southport Mall

P.O. Box 10631

Jackson, Mississippi 39209

WATER WELL DRILLERS LOG

PEARL RIVER
U 2076

July 26 85 19 Walshes Welding Pearl River
date well completed firm name county well located

LANDOWNER: Roy Roberts
Picayune Miss
Part 2
(mailing address)

description of formations encountered	from	to
<u>Red clay</u>	<u>0</u>	<u>15</u>
<u>Sand</u>	<u>15</u>	<u>19</u>
<u>Blue shell</u>	<u>19</u>	<u>172</u>
<u>Sand, brisqual</u>	<u>172</u>	<u>200</u>


WELL LOCATION:
sec 22 T 5 S R 12 E
5 miles NW Picayune
(distance) (direction) (nearest town)

WELL PURPOSE: Home
(home, irrigation, municipal, industrial)

WELL COMPLETION DATA:

- (1) diameter (inches) 2"
- (2) total depth (feet) 200'
- (3) static water level (feet) 12 below top of ground.
- (4) casing PVC, 190'
(material) (depth)
(size) If telescope see back.
- (5) screen 10', 190
(length) (depth to top)
10/10, PVC
(size) (material)
- (6) pump 1/2, 6
(HP) (yield gpm)
Electric
(type power)
- (7) electric log _____
(yes or no)
(organization running log)
- (8) how well bottom plugged Sand
shank


DRILLERS REMARKS:

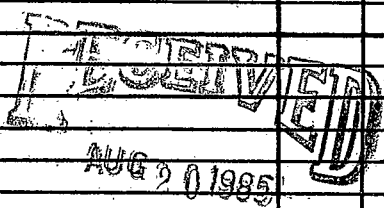

Department of Natural Resources
Bureau of Land & Water Resources

If well telescopes please sketch and show depths.

GROUND LEVEL

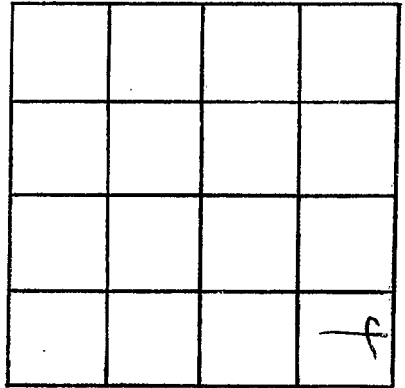

SECTION _____

Please indicate well location X.

ADDITIONAL INFORMATION

If more than one screen,
show locations of each on sketch.