

MISSISSIPPI DEPARTMENT OF NATURAL RESOURCES

Bureau of Land and Water Resources

Southport Mall

P.O. Box 10631

Jackson, Mississippi 39209

WATER WELL DRILLERS LOG

PEARL RIVER

42077

July 29-85
date well completed

Walker Welding
firm name

Pearl River
county well located

LANDOWNER: Raymond
Raymond
P.O. Box 111
(mailing address)

description of formations encountered	from	to
red clay	0	38
sand pit	38	80
gravel		

WELL LOCATION:
sec 2 T 5 N R 17 E
S Rock Ranch Road
18 miles NW of Pearl
(distance) (direction) (nearest town)

WELL PURPOSE:
(home, irrigation, municipal, industrial)

WELL COMPLETION DATA:

- (1) diameter (inches) 4"
- (2) total depth (feet) 80'
- (3) static water level (feet) 38' below top of ground.
- (4) casing PVC 30' (material) (depth)
(size) if telescope see back.
- (5) screen 10' 80' (length) (depth to top)
10' PVC (size) (material)
- (6) pump 1/2 8 (HP) (yield gpm)
Elect (type power)
- (7) electric log (yes or no)
- (organization running log)
- (8) how well bottom plugged SS


RECEIVED
AUG 20 1985

Department of Natural Resources
Bureau of Land & Water Resources

DRILLERS REMARKS:

If well telescopes please sketch and show depths.

GROUND LEVEL

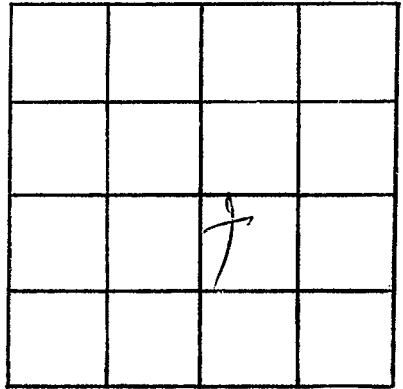

SECTION _____

Please indicate well location X.

ADDITIONAL INFORMATION

If more than one screen,
show locations of each on sketch.