

MISSISSIPPI DEPARTMENT OF NATURAL RESOURCES

Bureau of Land and Water Resources

Southport Mall

P.O. Box 10631

Jackson, Mississippi 39209

WATER WELL DRILLERS LOG

Pearl River
U 2078

11/14 1985
date well completed

Pennantson
firm name

Pearl River
county well located

LANDOWNER:	description of formations encountered	from	to
<u>R.T.C. Box 152</u>	<u>Red shale</u>	<u>0</u>	<u>40</u>
	<u>white sand</u>	<u>40</u>	<u>63</u>
	<u>Blue shale</u>	<u>63</u>	<u>180</u>
	<u>gray sand</u>	<u>180</u>	<u>250</u>

(mailing address)

WELL LOCATION:

sec. 8 T. 5 N. R. 17 E
S W
5 miles NO W of Diquette
(distance) (direction) (nearest town)

WELL PURPOSE: home
(home, irrigation, municipal, industrial)


WELL COMPLETION DATA:

- (1) diameter (inches) 2
- (2) total depth (feet) 250
- (3) static water level (feet) 14 below above top of ground.
- (4) casing PVC, 250
(material) (depth)
30 if telescope see back.
(size)
- (5) screen 2x10, 240
(length) (depth to top)
12, PVC
(size) (material)
- (6) pump 20
(HP) (yield gpm)
no
(type power)
- (7) electric log no
(yes or no)

(organization running log)

(8) how well bottom plugged plug
mark


DRILLERS REMARKS: no pump
furnished

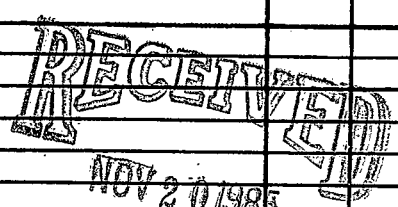

Department of Natural Resources
Bureau of Land & Water Resources

If well telescopes please sketch and show depths.

GROUND LEVEL

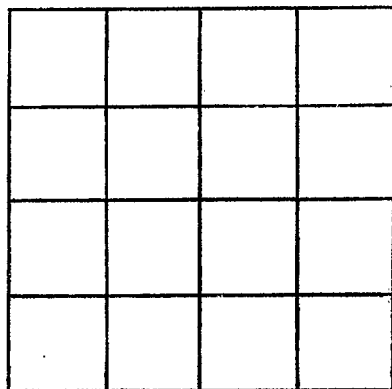

SECTION _____

Please indicate well location X.

ADDITIONAL INFORMATION

If more than one screen, show locations of each on sketch.