

MISSISSIPPI DEPARTMENT OF NATURAL RESOURCES

Bureau of Land and Water Resources

Southport Mall

P.O. Box 10631

Jackson, Mississippi 39209

WATER WELL DRILLERS LOG

BUD PENTON & SONS

firm name county well located

Barre River  
U137 207A  
7-18-85

7/18 1985  
 date well completed

LANDOWNER: Dean Westbrook  
R.T. 6 Box 2 95  
Picoune Miss.  
 (mailing address)

description of formations encountered	from	to
<u>Red Spale</u>	<u>0</u>	<u>28</u>
<u>Blue Spale</u>	<u>28</u>	<u>300</u>
<u>Grey Sand</u>	<u>310</u>	<u>342</u>

WELL LOCATION:  
 sec. 35 T. 5 N. R. 17 E.  
2 miles NW of Picoune  
 (distance) (direction) (nearest town)

WELL PURPOSE: home  
 (home, irrigation, municipal, industrial)

- WELL COMPLETION DATA:
- (1) diameter (inches) 2
  - (2) total depth (feet) 342
  - (3) static water level (feet) 27 below above top of ground.
  - (4) casing PVC, 342  
 (material) (depth)  
30 if telescope see back.  
 (size)
  - (5) screen 10, 332  
 (length) (depth to top)  
12, PVC  
 (size) (material)
  - (6) pump 1/2, 450  
 (HP) (yield gpm)  
Elite  
 (type power)
  - (7) electric log no  
 (yes or no)

(organization running log)

(8) how well bottom plugged Shard


DRILLERS REMARKS:

RECEIVED  
 NOV 15 1985

Department of Natural Resources  
 Bureau of Land & Water Resources

If well telescopes please  
sketch and show depths.

GROUND LEVEL

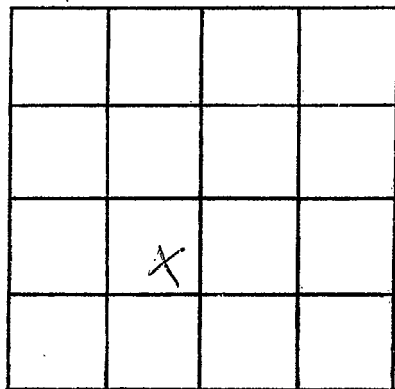

SECTION \_\_\_\_\_

Please indicate well location X.

ADDITIONAL INFORMATION

If more than one screen,  
show locations of each on sketch.