

MISSISSIPPI DEPARTMENT OF NATURAL RESOURCES

Bureau of Land and Water Resources

Southport Mall

P.O. Box 10631

Jackson, Mississippi 39209

WATER WELL DRILLERS LOG

Pearl River
U19 2081
10-2-85

10/2 1985 PENTON'S SON Pearl River
 date well completed firm name county well located

LANDOWNER: Charles Beck
R T. C. Payne
Miss.
 (mailing address)

description of formations encountered	from	to
<u>Red shale</u>	<u>0</u>	<u>16</u>
<u>White sand</u>	<u>16</u>	<u>63</u>
<u>Blue shale</u>	<u>63</u>	<u>300</u>
<u>Gray sand</u>	<u>300</u>	<u>355</u>


WELL LOCATION:
 sec. 2 T. 5 N R. 17 E
3 miles NW of Payne
 (distance) (direction) (nearest town)

WELL PURPOSE: home
 (home, irrigation, municipal, industrial)

- WELL COMPLETION DATA:
- (1) diameter (inches) 2
 - (2) total depth (feet) 355
 - (3) static water level (feet) 21 below above top of ground.
 - (4) casing PVC, 355'
 (material) (depth)
no if telescope see back.
 (size)
 - (5) screen 2x10, 345'
 (length) (depth to top)
10, PVC
 (size) (material)
 - (6) pump 1/2, 1000
 (HP) (yield gpm)
Elect.
 (type power)
 - (7) electric log no
 (yes or no)

(organization running log)
 (8) how well bottom plugged good
Shank


DRILLERS REMARKS:

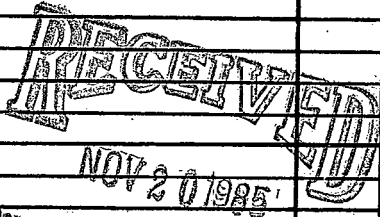

Department of Natural Resources
 Bureau of Land & Water

If well telescopes please sketch and show depths.

GROUND LEVEL

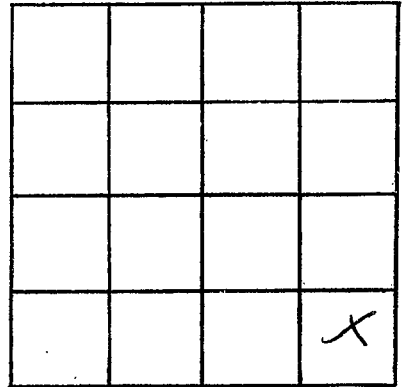

SECTION _____

Please indicate well location X.

ADDITIONAL INFORMATION

If more than one screen, show locations of each on sketch.