

MISSISSIPPI DEPARTMENT OF NATURAL RESOURCES
Bureau of Land and Water Resources
 Southport Mall
 P.O. Box 10631
 Jackson, Mississippi 39209
WATER WELL DRILLERS LOG

Pearl River
U 2082

March 6 19 86 Walker Welding Pearl River
 date well completed firm name county well located

LANDOWNER: Michael Mitchell
 Rt. 4 Box 464
 Carriere, Miss. 39426
 (mailing address)

description of formations encountered	from	to
	Clay	0
Sand	162	255

WELL LOCATION:
 sec. 11 T. 5 N R. 17 E
 12 (S) (W)
 _____ miles _____ of Picayune
 (distance) (direction) (nearest town)

WELL PURPOSE: Home
 (home, irrigation, municipal, industrial)

- WELL COMPLETION DATA:**
- (1) diameter (inches) 2 1/2
 - (2) total depth (feet) 255'
 - (3) static water level (feet) 64 below above top of ground.
 - (4) casing PVC 2 1/2
 (material) (depth)
 _____ if telescope see back.
 (size)
 - (5) screen 10' 2 1/2
 (length) (depth to top)
#12 PVC
 (size) (material)
 - (6) pump 1 8
 (HP) (yield gpm)

 (type power)
 - (7) electric log _____
 (yes or no)

 (organization running log)
 - (8) how well bottom plugged _____
 Sand Shark


DRILLERS REMARKS:

REGISTERED
WELL DRILLER
W. J. SIMS
 MAR 27 1986

Department of Natural Resources
 Bureau of Land & Water

If well telescopes please
sketch and show depths.

GROUND LEVEL

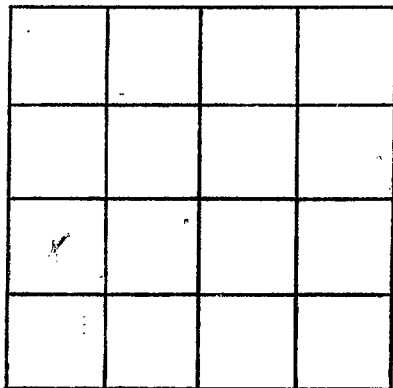

SECTION _____

Please indicate well location X.

ADDITIONAL INFORMATION

If more than one screen,
show locations of each on sketch.