

MISSISSIPPI DEPARTMENT OF NATURAL RESOURCES

Bureau of Land and Water Resources

Southport Mall

P.O. Box 10631

Jackson, Mississippi 39209

WATER WELL DRILLERS LOG

PEARL RIVER  
U 2083

3-24-86<sup>19</sup> date well completed      PENTON Well Service firm name      PEARL RIVER county well located

LANDOWNER: L. D. Mitchell

Hwy 43 NORTH

(mailing address)

WELL LOCATION:

sec 31 T 5 N R 17 E  
S W  
2 miles WEST of PICAYUNE  
(distance) (direction) (nearest town)

WELL PURPOSE: HOME  
(home, irrigation, municipal, industrial)

WELL COMPLETION DATA:

- (1) diameter (inches) 2"
- (2) total depth (feet) 327'
- (3) static water level (feet) 18' below above top of ground.
- (4) casing PVC, 317'  
(material) (depth)  
2" if telescope see back.  
(size)
- (5) screen 10', 317'  
" (length) (depth to top)  
2" PVC  
(size) (material)
- (6) pump \_\_\_\_\_ (HP) \_\_\_\_\_ (yield gpm)  
(type power)
- (7) electric log No  
(yes or no)  
(organization running log)
- (8) how well bottom plugged B.W.

description of formations encountered

from

to


CLAY	0	30
SAND + GRAVEL	30	65
CLAY	65	140
SAND	140	175
CLAY	175	250
SAND	250	327

MISSISSIPPI DEPARTMENT OF NATURAL RESOURCES  
BUREAU OF LAND AND WATER RESOURCES  
APR 1 1986  
JACKSON, MISSISSIPPI

DRILLERS REMARKS:

If well telescopes please sketch and show depths.

GROUND LEVEL

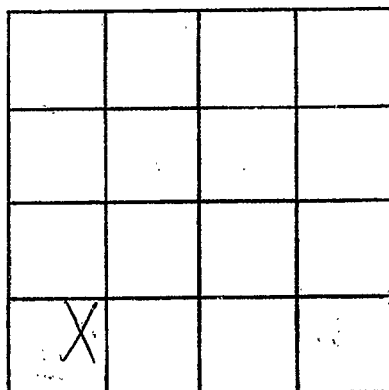

SECTION \_\_\_\_\_

Please indicate well location X.

ADDITIONAL INFORMATION

If more than one screen,  
show locations of each on sketch.