

MISSISSIPPI DEPARTMENT OF NATURAL RESOURCES

Bureau of Land and Water Resources

Southport Mall

P.O. Box 10631

Jackson, Mississippi 39209

WATER WELL DRILLERS LOG

PEARL RIVER  
U 2084

5-9 1986 PENTON WELL SERV PEARL RIVER  
date well completed firm name county well located

LANDOWNER: WALTER POMELAU  
KINGSBAY, LOT 46,  
PICAYUNE, MS. 39466  
(mailing address)


description of formations encountered	from	to
	CLAY	0
SAND	20	65
CLAY	65	260
SAND	260	326

WELL LOCATION:  
sec. 31 T. 5 N R. 17 E  
3 miles WEST of PICAYUNE  
(distance) (direction) (nearest town)

WELL PURPOSE: HOME  
(home, irrigation, municipal, industrial)

WELL COMPLETION DATA:

- (1) diameter (inches) 2"
- (2) total depth (feet) 326'
- (3) static water level (feet) 18' below above top of ground.
- (4) casing PVC 3 1/2'  
(material) (depth)  
2"  
(size) if telescope see back.
- (5) screen 10' 3 1/2'  
(length) (depth to top)  
2" PVC  
(size) (material)
- (6) pump 1/2   
(HP) (yield gpm)  
Elec  
(type power)
- (7) electric log No  
(yes or no)
- (organization running log)
- (8) how well bottom plugged BW

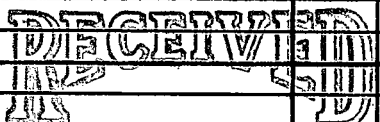


MAY 20 1986

Department of Natural Resources  
Bureau of Land & Water Resources

DRILLERS REMARKS:

If well telescopes please sketch and show depths.

GROUND LEVEL

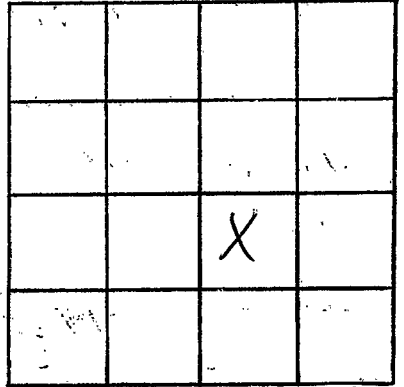

SECTION \_\_\_\_\_

Please indicate well location X.

ADDITIONAL INFORMATION

If more than one screen, show locations of each on sketch.