

MISSISSIPPI DEPARTMENT OF NATURAL RESOURCES

Bureau of Land and Water Resources

Southport Mall

P.O. Box 10631

BUDGET, JACKSON, MISSISSIPPI 39209
WATER WELL DRILLERS LOG

Rt. 4, Box 402

Carriere, Mississippi 39426

PHONE 601 - 798-5324 county well located

PEARL RIVER
40087

5/14

1986

date well completed

PEARL RIVER

LANDOWNER: Richard Ashes

description of formations encountered

from

to

RT-4 Box 159 Carriere

Red shale
white sand
Blue shale
gray sand

0 21
21 90
90 340
340 399

(mailing address)

WELL LOCATION:

sec. 31 T. 5 N R. 17 E
S W
2 miles W of Carriere
(distance) (direction) (nearest town)


WELL PURPOSE: home
(home, irrigation, municipal, industrial)

WELL COMPLETION DATA:

- (1) diameter (inches) 2"
- (2) total depth (feet) 399
- (3) static water level (feet) 21 below above top of ground.
- (4) casing PVC, 399,
(material) (depth)
NO if telescope see back.
(size)
- (5) screen 10, 388
(length) (depth to top)
12, PVC
(size) (material)
- (6) pump NO
(HP) (yield gpm)
(type power)
- (7) electric log _____
(yes or no)
(organization running log)

(8) how well bottom plugged and
shut


DRILLERS REMARKS: NO pump
furnished

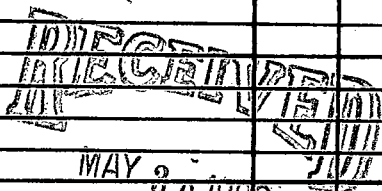

Department of Natural Resources
Bureau of Land & Water Resources

If well telescopes please
sketch and show depths.

GROUND LEVEL

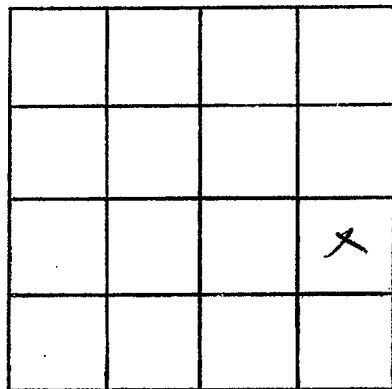

SECTION _____

Please indicate well location X.

ADDITIONAL INFORMATION

If more than one screen,
show locations of each on sketch.