

PEARL RIVER
U 2088

MISSISSIPPI DEPARTMENT OF NATURAL RESOURCES
 Bureau of Land and Water Resources
 Southport Mall
 P.O. Box 10631
 Jackson, Mississippi 39209
WATER WELL DRILLERS LOG

Aug 26 19 86 Walkers welding & repair Pearl river
 date well completed firm name county well located


LANDOWNER: James Cores
RTI Carriere Miss
 (mailing address)

description of formations encountered	from	to
<u>Blue Clay</u>	<u>0 0</u>	<u>20</u>
<u>Good Sand</u>	<u>20</u>	<u>42</u>

WELL LOCATION:
 sec 19 T 5 N R 19 E
17 miles N W of Picayune
 (distance) (direction) (nearest town)

WELL PURPOSE: home
 (home, irrigation, municipal, industrial)

- WELL COMPLETION DATA:
- (1) diameter (inches) 2 1/2
 - (2) total depth (feet) 42
 - (3) static water level (feet) 20 below top of ground.
 - (4) casing PVC 32
 (material) (depth)
 (size) if telescope see back.
 - (5) screen 10 32
 (length) (depth to top)
#10 PVC
 (size) (material)
 - (6) pump M
 (HP) (yield gpm)
 (type power)
 - (7) electric log (yes or no)
 (organization running log)
 - (8) how well bottom plugged Sand break

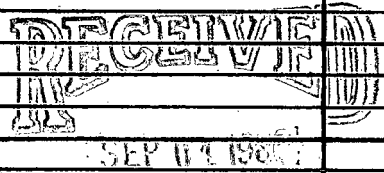

Department of Natural Resources
 Bureau of Land and Water Resources

DRILLERS REMARKS:

If well telescopes please sketch and show depths.

GROUND LEVEL

00 00
S' OS

SECTION

I I
00 0

			US

SECTION _____

Please indicate well location X.

ADDITIONAL INFORMATION

US
IS

IS

IS

SE

IS

If more than one screen, show locations of each on sketch.