

MISSISSIPPI DEPARTMENT OF NATURAL RESOURCES

Bureau of Land and Water Resources

Southport Mall

P.O. Box 10631

Jackson, Mississippi 39209

WATER WELL DRILLERS LOG

PEARL RIVER  
U 2089

5/28 date well completed      1986 BUD PENTON PEARL RIVER  
WATER SERVICE mm name county well located

LANDOWNER: Curt Glasgow  
R-T-1 Box  
Carrier Miss, 39066  
(mailing address)

description of formations encountered	from	to
<u>RED SHALE</u>	<u>0</u>	<u>46</u>
<u>RED SAND</u>	<u>46</u>	<u>70</u>
<u>BLUE SHALE</u>	<u>70</u>	<u>92</u>
<u>GRAY SAND</u>	<u>92</u>	<u>97</u>
<u>BLUE SHALE</u>	<u>97</u>	<u>450</u>
<u>GRAY SAND</u>	<u>450</u>	<u>485</u>

WELL LOCATION:  
sec. 17 T 5 N R. 17 E  
S W  
6 miles W of CARRIER  
(distance) (direction) (nearest town)

WELL PURPOSE: HOME  
(home, irrigation, municipal, industrial)


WELL COMPLETION DATA:

- (1) diameter (inches) 4"
- (2) total depth (feet) 485
- (3) static water level (feet) 120 below above top of ground.
- (4) casing PVC, 485,  
(material) (depth)  
(size) if telescope see back.
- (5) screen 12', 470  
(length) (depth to top)  
12, PVC  
(size) (material)
- (6) pump 1, 900  
(HP) (yield gpm)  
Elec.  
(type power)
- (7) electric log no  
(yes or no)

(organization running log)

(8) how well bottom plugged hard


DRILLERS REMARKS:

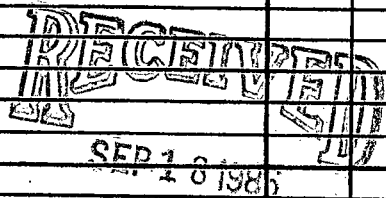

Department of Natural Resources  
Bureau of Land & Water

If well telescopes please sketch and show depths.

GROUND LEVEL

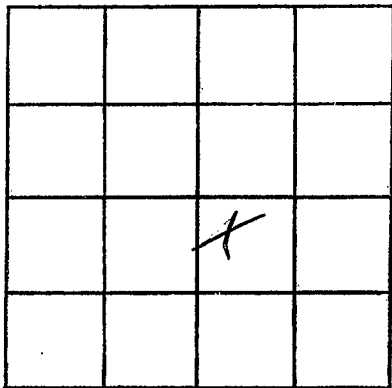

SECTION \_\_\_\_\_

Please indicate well location X.

ADDITIONAL INFORMATION

If more than one screen, show locations of each on sketch.