

MISSISSIPPI DEPARTMENT OF NATURAL RESOURCES

Bureau of Land and Water Resources

Southport Mall

P.O. Box 10631

Jackson, Mississippi 39209

WATER WELL DRILLERS LOG

Paul Rivers
U 2074

4/29 19 87 Rudenton Paul Rivers
 date well completed firm name county well located
Waters Well Service

LANDOWNER: Paul Trulls
R.T. Cassid Road
Picayune Miss.
 (mailing address)

description of formations encountered	from	to
<u>white shale</u>	<u>0</u>	<u>20</u>
<u>white sand</u>	<u>20</u>	<u>62</u>
<u>blue shale</u>	<u>62</u>	<u>270</u>
<u>gray sand</u>	<u>270</u>	<u>315</u>

WELL LOCATION:
 sec. 34 T 5 N R. 17 E
 S W
1 miles West Picayune
 (distance) (direction) (nearest town)

WELL PURPOSE: Home
 (home, irrigation, municipal, industrial)

WELL COMPLETION DATA:

- (1) diameter (inches) 2
- (2) total depth (feet) 315
- (3) static water level (feet) 22 below above top of ground.
- (4) casing pvc, 315,
 (material) (depth)
- (size) if telescope see back.
- (5) screen 10, 305
 (length) (depth to top)
- 1/2, pvc
 (size) (material)
- (6) pump 1/2, 450
 (HP) (yield gpm)
- Elect
 (type power)
- (7) electric log no
 (yes or no)

RECEIVED

JUN 16 1987

Department of Natural Resources
 Bureau of Land & Water Resources


(organization running log)

(8) how well bottom plugged sharp

DRILLERS REMARKS:

If well telescopes please sketch and show depths.

GROUND LEVEL

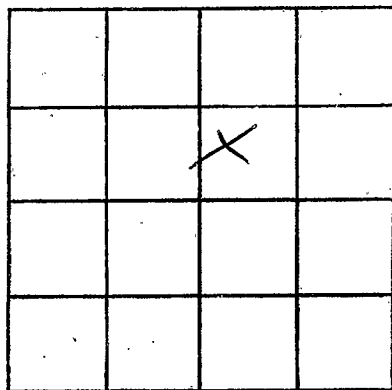

SECTION _____

Please indicate well location X.

ADDITIONAL INFORMATION

If more than one screen,
show locations of each on sketch.