

MISSISSIPPI DEPARTMENT OF NATURAL RESOURCES

Bureau of Land and Water Resources

Southport Mall

P.O. Box 10631

Jackson, Mississippi 39209

WATER WELL DRILLERS LOG

PEARL RIVER
U 2094

10/14 1987 Bud Peters Pearl River
date well completed firm name county well located
Water Well Service

LANDOWNER	description of formations encountered	from	to
Earl Cortney	white shale	0	25
R.T. 6 Liberty Road	white sand	25	60
(mailing address)	Blue shale	60	310
	gray sand	310	365

WELL LOCATION:
sec. 29 T 5 N R 17 E
S W
2 miles north of picone
(distance) (direction) (nearest town)

WELL PURPOSE: home
(home, irrigation, municipal, industrial)

- WELL COMPLETION DATA:
- (1) diameter (inches) 2"
 - (2) total depth (feet) 365
 - (3) static water level (feet) 21 below above top of ground.
 - (4) casing plc, 335
(material) (depth)
20 if telescope see back.
(size)
 - (5) screen 10, 365
(length) (depth to top)
12, pvc
(size) (material)
 - (6) pump 1/2, 450
(HP) (yield gpm)
Elect
(type power)
 - (7) electric log no
(yes or no)

(organization running log)
(8) how well bottom plugged plugged
none

DRILLERS REMARKS:


RECEIVED

APR 14 1988

Department of Natural Resources
Bureau of Land & Water Resources

If well telescopes please sketch and show depths.

GROUND LEVEL

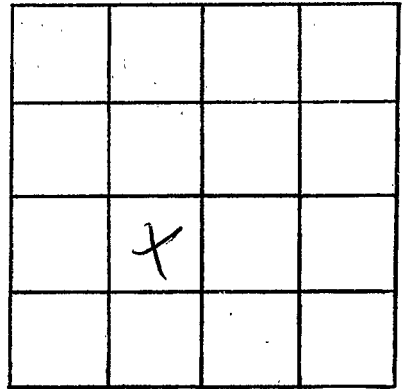

SECTION _____

Please indicate well location X.

ADDITIONAL INFORMATION

If more than one screen,
show locations of each on sketch.