

MISSISSIPPI DEPARTMENT OF NATURAL RESOURCES

Bureau of Land and Water Resources

P.O. Box 10631

Jackson, Mississippi 39209

WATER WELL DRILLERS LOG

COUNTY WELL LOCATED
PEARL River

WELL NUMBER **U 2598** CODED

DATE WELL COMPLETED
3-1-88

PERMIT NUMBER **0-477**

NAME OF DRILLING FIRM
PENTON WELL SERV.
Nicholson, MS.

NAME & MAILING ADDRESS OF LANDOWNER
M. L. Kelly (MRS.)
RT. 6 Box 90
PICAYUNE, MS. 39466

WELL LOCATION: SEC **29** TOWNSHIP **S** RANGE **17** W

DISTANCE **2** Miles DIRECTION **NE** of NEAREST TOWN **PICAYUNE**

OTHER LANDMARK

WELL PURPOSE: Home, Irrigation, Municipal, Industrial, Fish Pond, etc.
Home

PUMP DATA

PUMP TYPE (Circle One):
Submersible, Turbine, Jet, **Flowing Well**
Other (Describe) **AN Series**

POWER TYPE (Circle One):
Electric, Tractor, Diesel, Gasoline, Butane,
Other (Describe)

Pump Capacity (GPM)	No. of Stages	Setting Depth
		FT.

PUMP TEST

Well yielded _____ GPM with
a drawdown of _____ ft.
after _____ hours of pumping

WELL DATA

Well Depth 630'	Casing Diameter (In.) 2"	Casing Length (Ft.) 620'
Type of Casing PVC	Hole Depth 630'	Depth to Static Water Level Flow

TYPE OF COMPLETION: (Circle One or More):
Natural Development, Gravel Packed, Underreamed, Telescoped,
Open Hole, Other

Top of Lap Pipe or Reduction in Casing
FEET IF TELESCOPED OR MORE THAN ONE SCREEN: USE BACK PAGE

LOG DATA

TYPE OF LOG RUN (Circle One):
Electric, Gamma Ray, Density, Sonic, **No Log Run**,
Other (Describe)

Name of Organization Running Log

SCREEN DATA

Diameter - Inches 2"	Length - Feet 10'	Slot Size - Inches 10
Screen Type PVC	Depth to Bottom - Feet 630'	

GEOLOGIC DATA (Office Use Only)

Surface Elev.	Geologic Unit	Unit Thickness	Depth to Top
Subs. SWL	Date	Analysis	Aquifer Test


Driller's Remarks

DESCRIPTION OF FORMATIONS ENCOUNTERED	FROM	TO	FORMATIONS CONTINUED	FROM	TO
CLAY	0	15	NEGATIVE MAR 17 1988 Department of Natural Resources Bureau of Land & Water Resources		
SAND & GRAVEL	15	50			
CLAY	50	230			
SAND	230	355			
CLAY	355	580			
SAND	580	630			

IF MORE SPACE IS NEEDED, USE BACK

If well telescopes please
sketch and show depths.

GROUND LEVEL

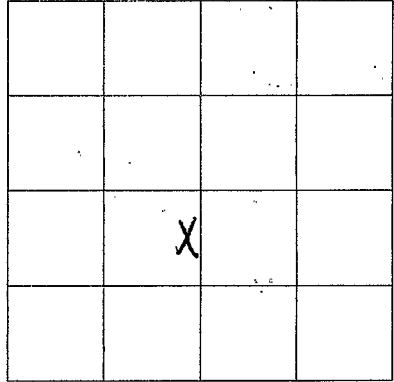

SECTION _____

Please indicate well location X.

ADDITIONAL INFORMATION

If more than one screen,
show location of each on sketch.