

MISSISSIPPI DEPARTMENT OF NATURAL RESOURCES

Bureau of Land and Water Resources

Southport Mall

P.O. Box 10631

Jackson, Mississippi 39209

WATER WELL DRILLERS LOG

P. River
U 2100

date well completed

19

firm name

county well located

Bud Penton & Son Pearl River

LANDOWNER:

Doil Watson

description of formations encountered

from

to

R.T. 6 Box 175-D
Prichard, Miss.
(mailing address)

<u>Red Shell</u>	<u>0</u>	<u>10</u>
<u>white sand</u>	<u>10</u>	<u>40</u>
<u>Blue shale</u>	<u>40</u>	<u>170</u>
<u>Blue sand</u>	<u>170</u>	<u>235</u>
<u>Blue shale</u>	<u>235</u>	<u>275</u>
<u>Gray sand</u>	<u>275</u>	<u>345</u>
<u>Blue shale</u>	<u>345</u>	<u>677</u>
<u>Gray sand</u>	<u>677</u>	<u>700</u>
<u>Blue shale</u>	<u>700</u>	<u>880</u>
<u>Gray sand</u>	<u>880</u>	<u>935</u>

WELL LOCATION:

sec. 23 T. 5 N. R. 17 E
2 miles SW of Carriere
(distance) (direction) (nearest town)

WELL PURPOSE:

home
(home, irrigation, municipal, industrial)


WELL COMPLETION DATA:

- (1) diameter (inches) 4"
- (2) total depth (feet) 935
- (3) static water level (feet) 40 below above top of ground.
- (4) casing PVC, 935,
(material) (depth)
(size) if telescope see back.
- (5) screen 15, 935
(length) (depth to top)
12, PVC
(size) (material)
- (6) pump 1 1/2, 30
(HP) (yield gpm)
- (7) electric log Elect
(type power)
- (7) electric log no
(yes or no)

(organization running log)

(8) how well bottom plugged sand
block

DRILLERS REMARKS:

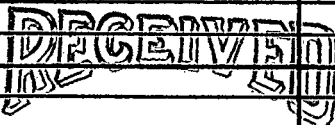

JUN 16 1988


Department of Natural Resources
Bureau of Land & Water Resources

If well telescopes please sketch and show depths.

GROUND LEVEL



If more than one screen, show locations of each on sketch.

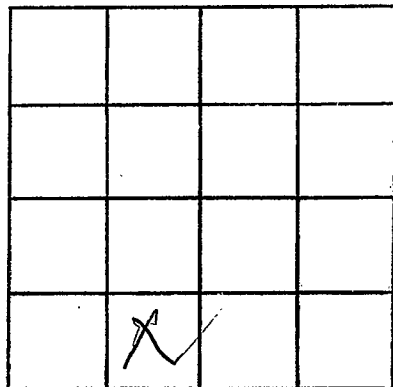

SECTION _____

Please indicate well location X.

ADDITIONAL INFORMATION

Lined area for additional information.