

MISSISSIPPI DEPARTMENT OF NATURAL RESOURCES

Bureau of Land and Water Resources

Southport Mall

P.O. Box 10631

Jackson, Mississippi 39209

WATER WELL DRILLERS LOG

P. River
U 2103

9/15 date well completed 1988 Bud Denton firm name Pearl River county well located

LANDOWNER: Lawrence E
Evans RT-6 Box 76 C
Picayune (mailing address)


description of formations encountered	from	to
<u>White shale</u>	<u>0</u>	<u>16</u>
<u>W. lite sand</u>	<u>16</u>	<u>60</u>
<u>Blue shale</u>	<u>60</u>	<u>218</u>
<u>2' red sand</u>	<u>218</u>	<u>246</u>
<u>Blde shale</u>	<u>246</u>	<u>600</u>
<u>2' red sand</u>	<u>600</u>	<u>650</u>

WELL LOCATION:
sec. 29 T 5 N R 17 E
S W
4 miles West of Picayune
(distance) (direction) (nearest town)

WELL PURPOSE: home
(home, irrigation, municipal, industrial)

WELL COMPLETION DATA:

- (1) diameter (inches) 2"
- (2) total depth (feet) 650
- (3) static water level (feet) 6 below/above top of ground.
- (4) casing PVC, 650,
(material) (depth)
 if telescope see back.
(size)
- (5) screen 15, 635
(length) (depth to top)
1/2, PVC
(size) (material)
- (6) pump no
(HP) (yield gpm)
 (type power)
- (7) electric log no
(yes or no)
 (organization running log)
- (8) how well bottom plugged good
short

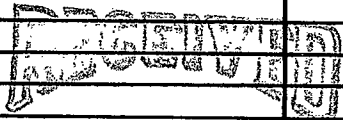


NOV 15 1988

Department of Natural Resources
Bureau of Land & Water Resources

DRILLERS REMARKS:

If well telescopes please sketch and show depths.

GROUND LEVEL

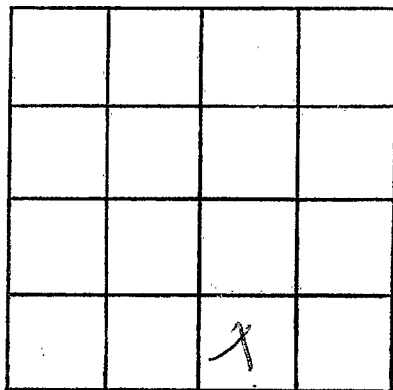

SECTION 29

Please indicate well location X.

ADDITIONAL INFORMATION

If more than one screen,
show locations of each on sketch.