

MISSISSIPPI DEPARTMENT OF NATURAL RESOURCES

Bureau of Land and Water Resources

Southport Mall

P.O. Box 10631

Jackson, Mississippi 39209

WATER WELL DRILLERS LOG

P. River  
U. 2104

7/28  
date well completed

1988 Bud Denton  
firm name

Pearl River  
county well located

LANDOWNER: Francis  
Phisonne R.T. 4 Box  
Carrier Miss 39426  
(mailing address)

description of formations encountered	from	to
Red Shale	0	60
Red sand / Rock	60	130
Blue shale	130	220
Gray sand	220	275
Blue shale	275	500
Gray sand	500	544

WELL LOCATION:  
sec. T 5 N R 17 E  
S W  
1/4 miles west of Carrier  
(distance) (direction) (nearest town)

WELL PURPOSE: farm  
(home, irrigation, municipal, industrial)

- WELL COMPLETION DATA:
- (1) diameter (inches) 4"
  - (2) total depth (feet) 544
  - (3) static water level (feet) 524 below top of ground
  - (4) casing PVC, 544 (material) (depth)  
(size) if telescope see back.
  - (5) screen 4x20, 524 (length) (depth to top)  
12, PVC (size) (material)
  - (6) pump 5 (HP) 90 (yield gpm)  
Elect (type power)
  - (7) electric log no (yes or no)  
(organization running log)
  - (8) how well bottom plugged sand


RECEIVED  
NOV 15 1988

Department of Natural Resources  
Bureau of Land & Water Resources

DRILLERS REMARKS:

If well telescopes please sketch and show depths.

GROUND LEVEL

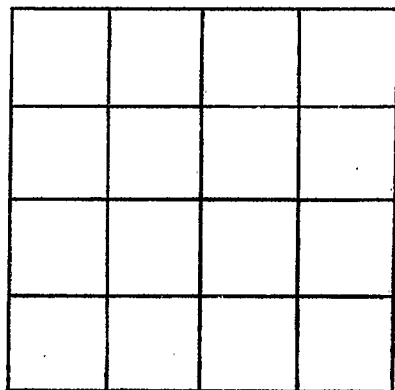

SECTION \_\_\_\_\_

Please indicate well location X.

ADDITIONAL INFORMATION

If more than one screen, show locations of each on sketch.