

## Bureau of Land and Water Resources

Jackson, Mississippi 39209  
WATER WELL DRILLERS LOG

COUNTY WELL LOCATED	
PEARL RIVER	
WELL NUMBER	CODED
4	
2105	
DATE WELL COMPLETED	
11-10-88	

PERMIT NUMBER	0428
NAME OF DRILLING FIRM	WACKER'S WELL DRILL

NAME & MAILING ADDRESS OF LANDOWNER

MIKE POWELL

Rt1 PICAYUNE

WELL LOCATION: SEC TOWNSHIP RANGE

9 5 N 12 E

DISTANCE DIRECTION NEAREST TOWN

10 Miles N of PICAYUNE

OTHER LANDMARK

WELL PURPOSE: Home, Irrigation, Municipal, Industrial, Fish Pond, etc.

PUMP DATA			
PUMP TYPE (Circle One):			
<u>Submersible</u>	Turbine,	Jet	Flowing Well,
Other (Describe) _____			
POWER TYPE (Circle One):			
<u>Electric</u>	Tractor,	Diesel,	Gasoline, Butane,
Other (Describe) _____			
Pump Capacity (GPM)	No. of Stages	Setting Depth	
2	8	40' FT.	
PUMP TEST			
Well yielded _____ GPM with			
a drawdown of _____ ft.			
after _____ hours of pumping			

WELL DATA		
Well Depth <b>430'</b>	Casing Diameter (In.) <b>4 1/2 X</b>	Casing Length (Ft.) <b>420</b>
Type of Casing <b>PVC</b>	Hole Depth <b>432</b>	Depth to Static Water Level <b>1'</b>
TYPE OF COMPLETION: (Circle One or More):		
<input checked="" type="checkbox"/> Gravel Packed,	<input type="checkbox"/> Underreamed,	<input type="checkbox"/> Telescoped,
<input checked="" type="checkbox"/> Natural Development,	<input type="checkbox"/> Open Hole,	<input type="checkbox"/> Other
(Describe) <b>AIR</b>		
Top of Lap Pipe or Reduction in Casing		
<b>160' FEET</b>	IF TELESCOPED OR MORE THAN ONE SCREEN: USE BACK PAGE	

LOG DATA	
TYPE OF LOG RUN (Circle One):	No Log Run,
Electric, Gamma Ray, Density, Sonic, Neutron,	
Other (Describe) _____	
Name of Organization Running Log	

SCREEN DATA		
Diameter - Inches 2"	Length - Feet 20'	Slot Size - Inches #8
Screen Type Slot		Depth to Bottom - Feet 430'

GEOLOGIC DATA (Office Use Only)			
Surface Elev.	Geologic Unit	Unit Thickness	Depth to Top
Subs. SWL	Date	Analysis	Aquifer Test
Driller's Remarks			


[illegible]

If well telescopes please  
sketch and show depths.

GROUND LEVEL

160' 4"

270' 2"

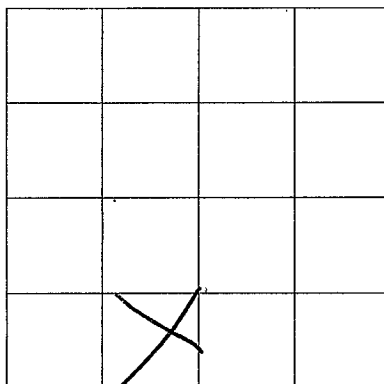

SECTION \_\_\_\_\_

Please indicate well location X.

ADDITIONAL INFORMATION

If more than one screen,  
show location of each on sketch.