

MISSISSIPPI DEPARTMENT OF NATURAL RESOURCES

Bureau of Land and Water Resources

Southport Mall

P.O. Box 10631

Jackson, Mississippi 39209

WATER WELL DRILLERS LOG

P. Rusk
U
2107

5/15 1989 Bud Penton Pearl River
date well completed firm name county well located

LANDOWNER: Noel Mills
George Wise Road
Carrier Miss.
(mailing address)

WELL LOCATION:
sec. 7 T. 3 N R. 17 E
S W
0.8 miles West Carrier
(distance) (direction) of (nearest town)

WELL PURPOSE: home
(home, irrigation, municipal, industrial)

WELL COMPLETION DATA:

- (1) diameter (inches) 4
- (2) total depth (feet) 569
- (3) static water level (feet) 70 below above top of ground.
- (4) casing PVC, 569 (material) (depth)
- 4x12 (size) if telescope see back.
- (5) screen 15, 554 (length) (depth to top)
- 12, PVC (size) (material)
- (6) pump 2, 27 (HP) (yield gpm)
- Elect (type power)
- (7) electric log no (yes or no)
- (organization running log)
- (8) how well bottom plugged, sand short

description of formations encountered	from	to
Red shale	0	15
Red sand	15	65
Blue shale	65	175
Blue sand	175	335
Blue shale	335	475
Grey sand	475	495
Blue shale	495	530
Grey sand	530	569


RECEIVED
MAY 24 1989

Department of Natural Resources
Bureau of Land & Water Resources

DRILLERS REMARKS:

If well telescopes please
sketch and show depths.

GROUND LEVEL

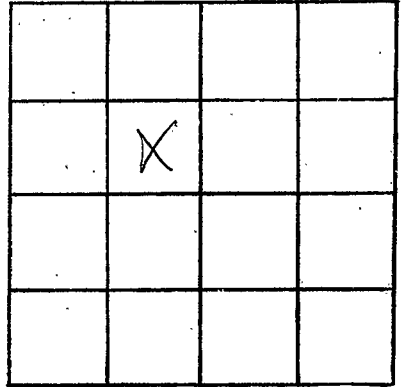

SECTION _____

Please indicate well location X.

ADDITIONAL INFORMATION

If more than one screen,
show locations of each on sketch.