

MISSISSIPPI DEPARTMENT OF NATURAL RESOURCES

Bureau of Land and Water Resources

P.O. Box 10631

Jackson, Mississippi 39209

WATER WELL DRILLERS LOG

COUNTY WELL LOCATED
PEARL RIVER

WELL NUMBER U	CODED
DATE WELL COMPLETED 9-1-89	

PERMIT NUMBER 0-428
NAME OF DRILLING FIRM WALKER'S WELL DRILLING SERVICE

NAME & MAILING ADDRESS OF LANDOWNER
Duby Williams
Picayune Miss
Rant to Cavender Miss

WELL LOCATION: SEC **32** TOWNSHIP **5** RANGE **17**
N **E**
W

DISTANCE **0** Miles **N** of **PICAYUNE**

OTHER LANDMARK
PICAYUNE

WELL PURPOSE: Home, Irrigation, Municipal, Industrial, Fish Pond, etc.

PUMP DATA

PUMP TYPE (Circle One):
Submersible, Turbine, **Flowing Well**,
Other (Describe) **FSC**

POWER TYPE (Circle One):
 Electric, Tractor, Diesel, Gasoline, Butane,
Other (Describe)

Pump Capacity (GPM) 8	No. of Stages 1	Setting Depth 20 FT.
---------------------------------	---------------------------	--------------------------------

PUMP TEST
Well yielded _____ GPM with
a drawdown of _____ ft.
after _____ hours of pumping

WELL DATA

Well Depth 290	Casing Diameter (In.) 2	Casing Length (Ft.) 280
Type of Casing PUC	Hole Depth 290	Depth to Static Water Level 8 FT

TYPE OF COMPLETION: (Circle One or More):
Gravel Packed, Underreamed, Telescoped,
 Natural Development, Open Hole, Other
(Describe) **AK**

Top of Lap Pipe or Reduction in Casing
FEET IF TELESCOPED OR MORE THAN ONE SCREEN: USE BACK PAGE

LOG DATA

TYPE OF LOG RUN (Circle One):
 No Log Run,
 Electric, Gamma Ray, Density, Sonic, Neutron,
Other (Describe)

Name of Organization Running Log

SCREEN DATA

Diameter - Inches 2	Length - Feet 10'	Slot Size - Inches 70
Screen Type SLOT	Depth to Bottom - Feet 290	

GEOLOGIC DATA (Office Use Only)

Surface Elev.	Geologic Unit	Unit Thickness	Depth to Top
Subs. SWL	Date	Analysis	Aquifer Test

Driller's Remarks

DESCRIPTION OF FORMATIONS ENCOUNTERED	FROM	TO
BLACK DIRT	0	10
WHITE CLAY	10	18
SAND	18	25
PEGRAULER	25	30
ROCK'S & SAND	30	80
BLUE CLAY	80	150
FINE BLUE SAND	150	200
BLUE CLAY	200	210
SAND	210	290

RECEIVED

OCT 09 1989


Department of Natural Resources
Bureau of Land & Water Resources

FORMATIONS (continued)	FROM	TO

IF MORE SPACE IS NEEDED, USE BACK

If well telescopes please sketch and show depths.

GROUND LEVEL

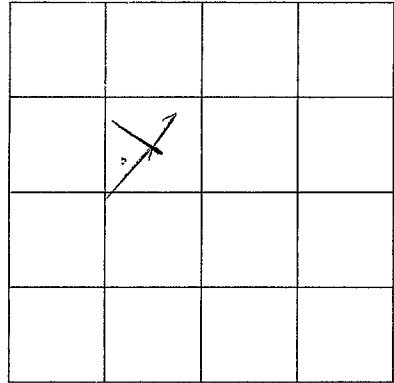

SECTION _____

Please indicate well location X.

ADDITIONAL INFORMATION

If more than one screen,
show location of each on sketch.