

MISSISSIPPI DEPARTMENT OF NATURAL RESOURCES

Bureau of Land and Water Resources

Southport Mall

P.O. Box 10631

Jackson, Mississippi 39209

WATER WELL DRILLERS LOG

P. R. Uen  
U 2114

8/25/89 date well completed

89 Bud Denton firm name

Pearl River county well located

LANDOWNER: Charles Porter

description of formations encountered	from	to
white shale	0	5
white sand	5	55
blue shale	55	160
hard blue	160	175
blue shale	175	250
blue sand to gravel	250	365
blue shale	365	757
gray sand	757	797

PO Box 1145 Piquette Miss.  
(mailing address)

WELL LOCATION:

sec 28 T 5 N R 17 E  
S W  
5 miles west of Piquette  
(distance) (direction) (nearest town)

WELL PURPOSE: home  
(home, irrigation, municipal, industrial)

WELL COMPLETION DATA:

- (1) diameter (inches) 2"
- (2) total depth (feet) 797
- (3) static water level (feet) 4 below top of ground.
- (4) casing PVC, 797 (material) (depth)

(size) If telescope see back.

- (5) screen 15, 782 (length) (depth to top)

1/2, PVC (size) (material)

- (6) pump 1/2, 450 (HP) (yield gpm)


(type power)

- (7) electric log no (yes or no)

(organization running log)

- (8) how well bottom plugged sand

DRILLERS REMARKS:

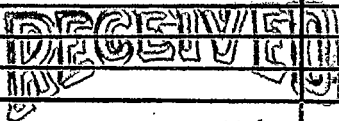


JAN 26 1990

Department of Natural Resources  
Bureau of Land & Water Resources

If well telescopes please sketch and show depths.

GROUND LEVEL

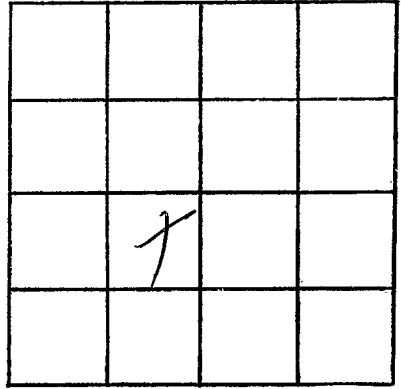

SECTION \_\_\_\_\_

Please indicate well location X.

ADDITIONAL INFORMATION

If more than one screen,  
show locations of each on sketch.