

MISSISSIPPI DEPARTMENT OF NATURAL RESOURCES

Bureau of Land and Water Resources

Southport Mall

P.O. Box 10631

Jackson, Mississippi 39209

WATER WELL DRILLERS LOG

P. RIVER
U
2115

8/1 1989 Bed penton, San Pearl River
date well completed firm name county well located

LANDOWNER Church
Perrette PO Box 1856
Carriere, Miss
(mailing address)

description of formations encountered	from	to
<u>Red shale</u>	<u>0</u>	<u>10</u>
<u>White sand</u>	<u>10</u>	<u>80</u>
<u>Blue shale</u>	<u>80</u>	<u>260</u>
<u>Blue sand no sand</u>	<u>260</u>	<u>399</u>
<u>Blue shale</u>	<u>399</u>	<u>526</u>
<u>Blue sand no sand</u>	<u>526</u>	<u>541</u>
<u>Blue shale</u>	<u>541</u>	<u>660</u>
<u>Gray sand</u>	<u>660</u>	<u>711</u>

WELL LOCATION:
sec. 24 T 5 N R 17 E
S W
2 miles South of Carriere
(distance) (direction) (nearest town)

WELL PURPOSE: Home
(home, irrigation, municipal, industrial)

- WELL COMPLETION DATA:
- (1) diameter (inches) 4 1/2"
 - (2) total depth (feet) 711
 - (3) static water level (feet) 69 below above top of ground.
 - (4) casing PVC 7 1/2" (material) (depth)
4 1/2" (size) If telescope see back.
 - (5) screen 15 (length) 696 (depth to top)
12 (size) PVC (material)
 - (6) pump 1 (HP) 850 (yield gpm)
Elect (type power)
 - (7) electric log no (yes or no)



JAN 26 1990

Department of Natural Resources
Bureau of Land & Water Resources

(organization running log)
(8) how well bottom plugged Sand


DRILLERS REMARKS:

If well telescopes please sketch and show depths.

GROUND LEVEL

200 ft. 4"

620 ft. 2.11

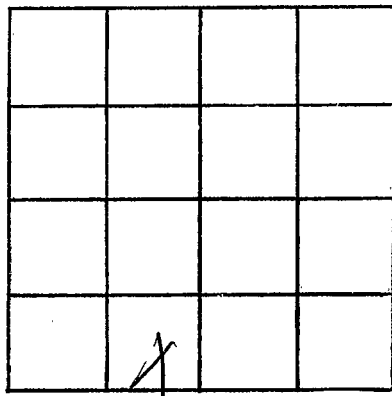

SECTION _____

Please indicate well location X.

ADDITIONAL INFORMATION

If more than one screen, show locations of each on sketch.