

MISSISSIPPI DEPARTMENT OF NATURAL RESOURCES

Bureau of Land and Water Resources

Southport Mall

P.O. Box 10631

Jackson, Mississippi 39209

WATER WELL DRILLERS LOG

P. P. Puse  
U 2123

5/28 1990 Bud Penton firm name Pearl River county well located

LANDOWNER: Jack Mcary  
R.T. 1 Box  
Carroll miss  
(mailing address)

description of formations encountered	from	to
	<u>Red shale</u>	<u>0</u>
<u>Red sand</u>	<u>20</u>	<u>90</u>
<u>Blue shale</u>	<u>90</u>	<u>18.5</u>
<u>Shof. sand</u>	<u>18.5</u>	<u>236</u>

WELL LOCATION:  
sec 20 T 5 N R 17 E  
6 miles W of Carroll  
(distance) (direction) (nearest town)

WELL PURPOSE: none  
(home, irrigation, municipal, industrial)

WELL COMPLETION DATA:

(1) diameter (inches) 2"

(2) total depth (feet) 236

(3) static water level (feet) 87 below above top of ground.

(4) casing pvc 236  
(material) (depth)

4xw if telescope see back.  
(size)

(5) screen 10 226  
(length) (depth to top)

12 pvc  
(size) (material)

(6) pump 1 360  
(HP) (yield gpm)

Elect  
(type power)

(7) electric log no  
(yes or no)

(organization running log)

(8) how well bottom plugged hard  
shark

DRILLERS REMARKS:


RECEIVED

OCT 15 1990

Department of Natural Resources  
Bureau of Land & Water

If well telescopes please sketch and show depths.

GROUND LEVEL

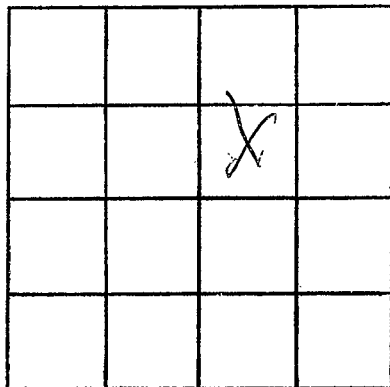

SECTION \_\_\_\_\_

Please indicate well location X.

ADDITIONAL INFORMATION

If more than one screen,  
show locations of each on sketch.