

MISSISSIPPI DEPARTMENT OF NATURAL RESOURCES

Bureau of Land and Water Resources

Southport Mall

P.O. Box 10631

Jackson, Mississippi 39209

WATER WELL DRILLERS LOG

Pearl River
U 2125

5/6-92 19 Bed Portation Pearl River
date well completed firm name county well located

LANDOWNER: Henry Jackson
R.T. 4 Box Carriev
Missi
(mailing address)

description of formations encountered	from	to
<u>Red Shale</u>	<u>0</u>	<u>30</u>
<u>Blue Shale</u>	<u>30</u>	<u>147</u>
<u>Grey Sand</u>	<u>147</u>	<u>168</u>

WELL LOCATION:
sec. 11 T. 8 N. R. 17 E
1/4 5 S West Carriev
(distance) miles (direction) of (nearest town)


WELL PURPOSE: home
(home, irrigation, municipal, industrial)

WELL COMPLETION DATA:

- (1) diameter (inches) 4
- (2) total depth (feet) 168
- (3) static water level (feet) 91 below above-top of ground.
- (4) casing pvc 168
(material) (depth)
(size) if telescope see back.
- (5) screen 10 158
(length) (depth to top)
12 pvc
(size) (material)
- (6) pump 1 20
(HP) (yield gpm)
Elect
(type power)
- (7) electric log 770
(yes or no)

(organization running log)
- (8) how well bottom plugged sand
shrub

DRILLERS REMARKS:

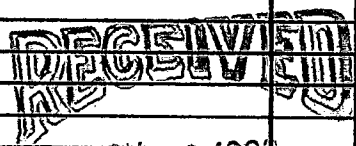


MAY 26 1992

Dept. of Environmental Quality
Bureau of Land & Water Resources

If well telescopes please sketch and show depths.

GROUND LEVEL

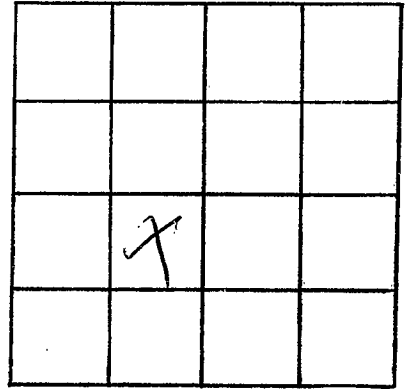

SECTION _____

Please indicate well location X.

ADDITIONAL INFORMATION

If more than one screen,
show locations of each on sketch.