

MISSISSIPPI DEPARTMENT OF NATURAL RESOURCES

Bureau of Land and Water Resources

Southport Mall

P.O. Box 10631

Jackson, Mississippi 39209

WATER WELL DRILLERS LOG

Pearl River
U 2126

5/15 - 1992 Bed Poston Pearl River
date well completed firm name county well located

LANDOWNER: Pat Earl
Damas Bally Rd
Picayune Miss
(mailing address)

| description of formations encountered | from | to |
|---------------------------------------|------------------|------------|
| | <u>Red shale</u> | <u>0</u> |
| <u>Red sand</u> | <u>17</u> | <u>67</u> |
| <u>Blue shale</u> | <u>67</u> | <u>203</u> |
| <u>gray sand</u> | <u>203</u> | <u>250</u> |

WELL LOCATION:
sec. 21 T. 5 N R. 17 E
S W
8 miles W Picayune
(distance) (direction) (nearest town)

WELL PURPOSE: home
(home, irrigation, municipal, industrial)

WELL COMPLETION DATA:

- (1) diameter (inches) 2
- (2) total depth (feet) 250
- (3) static water level (feet) 42 below top of ground.
- (4) casing pcc 250
(material) (depth)
(size) if telescope see back.
- (5) screen 10 240
(length) (depth to top)
8 pvc
(size) (material)
- (6) pump 1/2 6
(HP) (yield gpm)
Elect
(type power)
- (7) electric log no
(yes or no)

(organization running log)
(8) how well bottom plugged and
shale


DRILLERS REMARKS:

RECEIVED
JUN 08 1992

Dept. of Environmental Quality
Bureau of Land & Water Resources

If well telescopes please sketch and show depths.

GROUND LEVEL

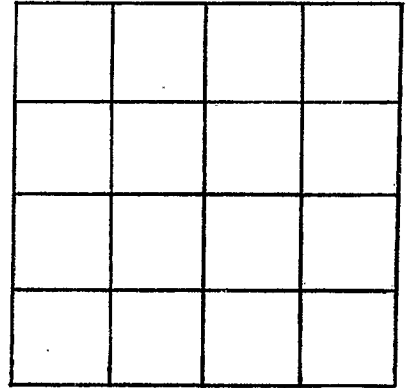

SECTION _____

Please indicate well location X.

ADDITIONAL INFORMATION

If more than one screen,
show locations of each on sketch.