

MISSISSIPPI DEPARTMENT OF NATURAL RESOURCES

Bureau of Land and Water Resources

Southport Mall

P.O. Box 10631

Jackson, Mississippi 39209

WATER WELL DRILLERS LOG

Paul River
U 2127

5/11 1992 Budget Water Well Drilling
date well completed firm name county well located

LANDOWNER: Jack Smith
Dumas Bailey Rd
(mailing address)

description of formations encountered	from	to
<u>Red shale</u>	<u>0</u>	<u>8</u>
<u>Red sand</u>	<u>0</u>	<u>37</u>
<u>Blue shale</u>	<u>37</u>	<u>197</u>
<u>Blue sand</u>	<u>197</u>	<u>302</u>

WELL LOCATION:
sec. 21 T. 5 N. R. 17 E.
S. W. W.
8 miles W of Preyer
(distance) (direction) (nearest town)


WELL PURPOSE: home
(home, irrigation, municipal, industrial)

WELL COMPLETION DATA:

- (1) diameter (inches) 2
- (2) total depth (feet) 302
- (3) static water level (feet) 30 below top of ground.
- (4) casing pvc, 302,
(material) (depth)
(size) if telescope see back.
- (5) screen 10, 282
(length) (depth to top)
12, pvc
(size) (material)
- (6) pump 1/2, 6
(HP) (yield gpm)
Elect
(type power)
- (7) electric log no
(yes or no)

(organization running log)
(8) how well bottom plugged land
shrub


DRILLERS REMARKS:

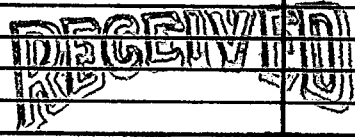

Dept. of Environmental Quality
Bureau of Land & Water Resources

If well telescopes please sketch and show depths.

GROUND LEVEL

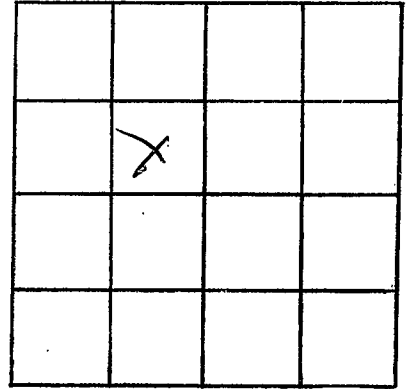

SECTION _____

Please indicate well location X.

ADDITIONAL INFORMATION

If more than one screen,
show locations of each on sketch.