

MISSISSIPPI DEPARTMENT OF NATURAL RESOURCES

Bureau of Land and Water Resources

Southport Mall

P.O. Box 10631

Jackson, Mississippi 39209

WATER WELL DRILLERS LOG

Pearl River
U 2128

5/12 1992
date well completed

Bud Denton
firm name

Pearl River
county well located

LANDOWNER: Willard
Nedguth Gorge Ford
Rd Carriere miss.
(mailing address)

description of formations encountered	from	to
<u>Red shale</u>	<u>0</u>	<u>8</u>
<u>Red sand</u>	<u>8</u>	<u>30</u>
<u>Blue shale</u>	<u>30</u>	<u>70</u>
<u>White sand</u>	<u>70</u>	<u>90</u>


WELL LOCATION:
sec. 10 T. 5 N. R. 17 E
S W
2 miles W of Carriere
(distance) (direction) (nearest town)

WELL PURPOSE: home
(home, irrigation, municipal, industrial)

- WELL COMPLETION DATA:
- (1) diameter (inches) 2
 - (2) total depth (feet) 90
 - (3) static water level (feet) 30 below top of ground.
 - (4) casing PVC 90
(material) (depth)
if telescope see back.
(size)
 - (5) screen 5 85
(length) (depth to top)
12 PVC
(size) (material)
 - (6) pump 1/2 8
(HP) (yield gpm)
Elect.
(type power)
 - (7) electric log no
(yes or no)

(organization running log)
(8) how well bottom plugged shard

DRILLERS REMARKS:

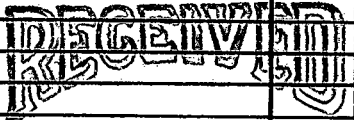


JUN 08 1992

Dept. of Environmental Quality
Bureau of Land & Water Resources

If well telescopes please sketch and show depths.

GROUND LEVEL

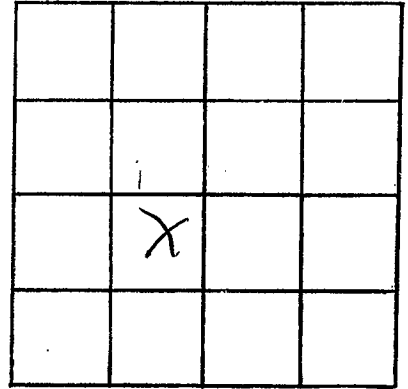

SECTION _____

Please indicate well location X.

ADDITIONAL INFORMATION

If more than one screen,
show locations of each on sketch.