

MISSISSIPPI DEPARTMENT OF NATURAL RESOURCES

Bureau of Land and Water Resources

Southport Mall

P.O. Box 10631

Jackson, Mississippi 39209

WATER WELL DRILLERS LOG

P. River
U 2130

8-14 19 92 Bud Penton Water Well Pearl River
date well completed firm name county well located

LANDOWNER: Kenny Russo
42 Lang Dr Carriere
Ms 39426
(mailing address)

description of formations encountered	from	to
white shale	0	21
white sand	21	65
blue shale	65	205
white sand	205	342

WELL LOCATION:
sec. 17 T S N R. 17 E
S W
5 miles W of Picayune
(distance) (direction) (nearest town)

WELL PURPOSE: Home
(home, irrigation, municipal, industrial)

- WELL COMPLETION DATA:
- (1) diameter (inches) .5
 - (2) total depth (feet) 342
 - (3) static water level (feet) 36 ^{below} _{above} top of ground.
 - (4) casing PVC, 332
(material) (depth)
2 if telescope see back.
(size)
 - (5) screen 10, 332
(length) (depth to top)
2, PVC
(size) (material)
 - (6) pump 1/2, 7
(HP) (yield gpm)
electric
(type power)
 - (7) electric log NO
(yes or no)
(organization running log)
 - (8) how well bottom plugged sandshark.


RECEIVED
SEP 16 1992

Dept. of Environmental Quality
Bureau of Land & Water Resources

DRILLERS REMARKS:

If well telescopes please sketch and show depths.

GROUND LEVEL

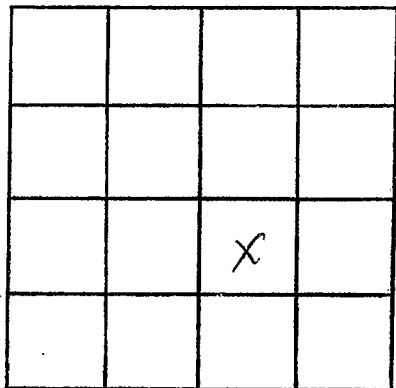

SECTION 17

Please indicate well location X.

ADDITIONAL INFORMATION

If more than one screen,
show locations of each on sketch.