

MISSISSIPPI DEPARTMENT OF NATURAL RESOURCES

Bureau of Land and Water Resources

Southport Mall

P.O. Box 10631

Jackson, Mississippi 39209

WATER WELL DRILLERS LOG

DR
AU
2131

2/7 1992 Budpertan Steel River
 date well completed firm name county well located

LANDOWNER: Gal Winan
Vigle Lewis Rd
Carriere Miss
Box 754 (mailing address)

description of formations encountered	from	to
Red shale	0	15
Red sand	15	25
Blue shale	25	190
Gray sand	190	275
Blue shale	275	408
Gray sand	408	525

WELL LOCATION:
 sec 21 T 3 N R 17 E
4 miles W of Carriere
 (distance) (direction) (nearest town)

WELL PURPOSE: none
 (home, irrigation, municipal, industrial)


WELL COMPLETION DATA:

- (1) diameter (inches) 4 X 2
- (2) total depth (feet) 525
- (3) static water level (feet) 57 below above-top of ground.
- (4) casing PVC 525
 (material) (depth)
4 X 2 if telescope see back.
 (size)
- (5) screen 10 573
 (length) (depth to top)
12 PVC
 (size) (material)
- (6) pump 1 22
 (HP) (yield gpm)
Elect
 (type power)
- (7) electric log no
 (yes or no)

(organization running log)

(8) how well bottom plugged hard

DRILLERS REMARKS: Shut

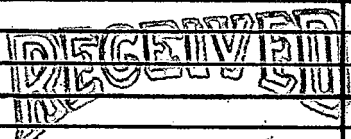


APR 29 1992

Dept. of Environmental Quality
 Bureau of Land & Water Resources

If well telescopes please sketch and show depths.

GROUND LEVEL

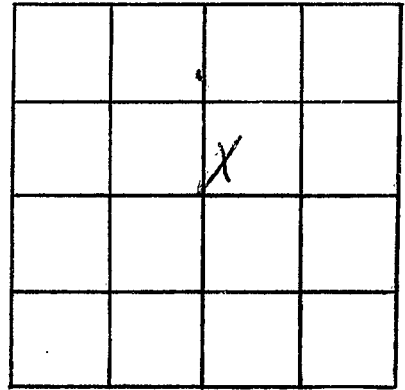

SECTION 21

Please indicate well location X.

ADDITIONAL INFORMATION

If more than one screen,
show locations of each on sketch.