

Pearl River  
U 2132

MISSISSIPPI DEPARTMENT OF NATURAL RESOURCES  
Bureau of Land and Water Resources  
Southport Mall  
P.O. Box 10631  
Jackson, Mississippi 39209  
**WATER WELL DRILLERS LOG**

8-16 1992 Bud Penton Water Well Pearl River  
date well completed firm name county well located

LANDOWNER: Carl Scott  
Rt 4 Carriere  
Ms 39426  
(mailing address)

description of formations encountered	from	to
<u>white shale</u>	<u>0</u>	<u>35</u>
<u>white sand</u>	<u>35</u>	<u>125</u>
<u>blue shale</u>	<u>125</u>	<u>175</u>

WELL LOCATION:  
sec. 12 T S N R 17 E  
S W  
1 miles W of Carriere  
(distance) (direction) (nearest town)

WELL PURPOSE: Home  
(home, irrigation, municipal, industrial)

- WELL COMPLETION DATA:
- (1) diameter (inches) 5
  - (2) total depth (feet) 175
  - (3) static water level (feet)      below above top of ground.
  - (4) casing PVC 175  
(material) (depth)  
1" if telescope see back.  
(size)
  - (5) screen            
(length) (depth to top)  
           
(size) (material)
  - (6) pump            
(HP) (yield gpm)  
      
(type power)
  - (7) electric log NO  
(yes or no)  
      
(organization running log)
  - (8) how well bottom plugged loop


RECEIVED  
SEP 18 1992

Dept. of Environmental Quality  
Bureau of Land & Water Resources

DRILLERS REMARKS: Loop  
system for air conditioner.  
No screen.

If well telescopes please sketch and show depths.

GROUND LEVEL

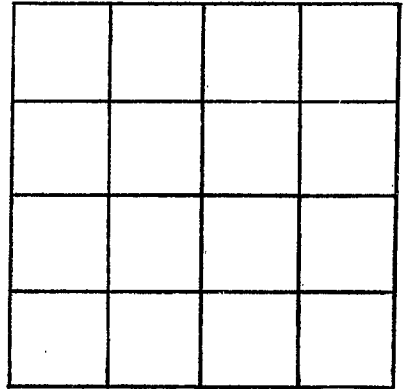

SECTION \_\_\_\_\_

Please indicate well location X.

ADDITIONAL INFORMATION

If more than one screen,  
show locations of each on sketch.