

MISSISSIPPI DEPARTMENT OF NATURAL RESOURCES

Bureau of Land and Water Resources

Southport Mall

P.O. Box 10631

Jackson, Mississippi 39209

WATER WELL DRILLERS LOG

P. River  
U 2135

6-16-92 Bud Penton Water Well Pearl River  
date well completed firm name county well located

LANDOWNER: Kevin Cazes  
Carriere MS 39426  
422 Dumas Baily Rd  
(mailing address)

description of formations encountered	from	to
White Shale	0	25
White sand	25	68
white shale	68	188
White sand	188	198

WELL LOCATION:  
sec. 29 T. 5 N R. 17 E  
S S W  
5 miles west of Picayune  
(distance) (direction) (nearest town)


WELL PURPOSE: Home  
(home, irrigation, municipal, industrial)

- WELL COMPLETION DATA:
- (1) diameter (inches) 5
  - (2) total depth (feet) 198
  - (3) static water level (feet) 32' below top of ground
  - (4) casing PVC 188'  
(material) (depth)  
2" If telescope see back.  
(size)
  - (5) screen 10' 188'  
(length) (depth to top)  
2" PVC  
(size) (material)
  - (6) pump 1/2 7  
(HP) (yield gpm)  
electric  
(type power)
  - (7) electric log NO  
(yes or no)

(organization running log)

(8) how well bottom plugged sandshank

DRILLERS REMARKS:

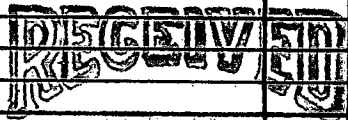

AUG 31 1992

Dept. of Environmental Quality  
Bureau of Land & Water Resources

If well telescopes please sketch and show depths.

GROUND LEVEL

	X		
	<del>X</del>		

SECTION 29

Please indicate well location X.

ADDITIONAL INFORMATION

If more than one screen,  
show locations of each on sketch.