

MISSISSIPPI DEPARTMENT OF NATURAL RESOURCES

Bureau of Land and Water Resources

Southport Mall

P.O. Box 10631

Jackson, Mississippi 39209

WATER WELL DRILLERS LOG

P. RIVON
U 2136
S

10-28 1992 Bud Penton Water Well Pearl River
date well completed firm name county well located

LANDOWNER: Joe Wheatley
Highway 3 North
Picayune MS 39466
(mailing address)

description of formations encountered	from	to
white clay	0	30
white sand	30	84
blue clay	84	294
GRAY sand	294	330
blue clay	330	1010
GRAY SAND	1010	1064


WELL LOCATION:

sec. 32 T 5 N R 17 E
S W
3 miles W of Picayune
(distance) (direction) (nearest town)

WELL PURPOSE: Home
(home, irrigation, municipal, industrial)

WELL COMPLETION DATA:

- (1) diameter (inches) 2"
- (2) total depth (feet) 1064
- (3) static water level (feet) flow below above top of ground.
- (4) casing PVC 1049
(material) (depth)
- 2 if telescope see back.
(size)
- (5) screen 15 1049
(length) (depth to top)
- 2 PVC
(size) (material)
- (6) pump — —
(HP) (yield gpm)
- (type power)
- (7) electric log NO
(yes or no)
- (organization running log)
- (8) how well bottom plugged Sandshark

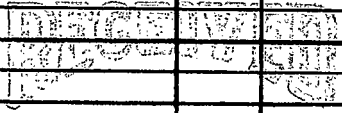


APR 20 1993

Dept. of Environmental Quality
Office of Land & Water Resources

DRILLERS REMARKS:

If well telescopes please sketch and show depths.

GROUND LEVEL

			
	X		

SECTION 32

Please indicate well location X.

ADDITIONAL INFORMATION

If more than one screen,
show locations of each on sketch.