

MISSISSIPPI DEPARTMENT OF NATURAL RESOURCES

Bureau of Land and Water Resources

Southport Mall

P.O. Box 10631

Jackson, Mississippi 39209

WATER WELL DRILLERS LOG

P. RIVER
U 2537

6-4 1992 Bud Penton Water Well Pearl River
date well completed firm name county well located

LANDOWNER: Sonny Stewart
Carrier Miss,
Dumas Baily Rd
(mailing address)

description of formations encountered

from to

White Shale	0	22
White Sand	22	60
Blue Shale	60	230
Blue Sand	230	300

WELL LOCATION:

sec. 29 T. 5 N R. 17 E
S W
5 miles west of Picayune
(distance) (direction) (nearest town)


WELL PURPOSE: Home
(home, irrigation, municipal, industrial)

WELL COMPLETION DATA:

- (1) diameter (inches) 2.5
- (2) total depth (feet) 300
- (3) static water level (feet) 45' ^{below} above top of ground.
- (4) casing PVC 290
(material) (depth)
- 2" if telescope see back.
(size)
- (5) screen 10' 290'
(length) (depth to top)
- 2" PVC
(size) (material)
- (6) pump 1/2 6
(HP) (yield gpm)
- electric
(type power)
- (7) electric log NO
(yes or no)

(organization running log)

(8) how well bottom plugged Sandshark

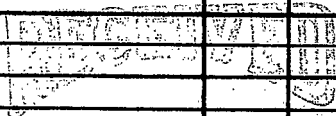


APR 28 1993

DRILLERS REMARKS:

Dept. of Environmental Quality
Office of Land & Water Resources

If well telescopes please sketch and show depths.

GROUND LEVEL

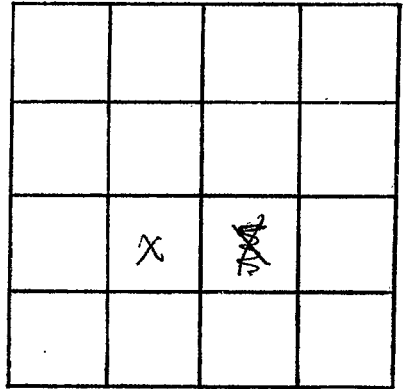

SECTION 29

Please indicate well location X.

ADDITIONAL INFORMATION

If more than one screen,
show locations of each on sketch.