

P. River
 U 2138

MISSISSIPPI DEPARTMENT OF NATURAL RESOURCES
 Bureau of Land and Water Resources
 Southport Mall
 P.O. Box 10631
 Jackson, Mississippi 39209
WATER WELL DRILLERS LOG

1-8 1988 Bud Penton Water Well Serv. Pearl River
 date well completed firm name county well located

LANDOWNER: Walter Mitchell
Dumas Bailey Rd
R. T. Currier
 (mailing address)

description of formations encountered	from	to
	red clay	0
white sand	15	48
blue clay	48	210
gray sand	210	273

WELL LOCATION:
 sec. 17 T 5 N R. 17 E
 S W
5 miles west of Picayune
 (distance) (direction) (nearest town)

WELL PURPOSE: Home
 (home, irrigation, municipal, industrial)

- WELL COMPLETION DATA:
- diameter (inches) 5 1/2
 - total depth (feet) 273
 - static water level (feet) 36 below above top of ground.
 - casing PVC, 263
 (material) (depth)
2 if telescope see back.
 (size)
 - screen 10, 263
2" (length) (depth to top)
PVC
 (size) (material)
 - pump 1/2, 10
 (HP) (yield gpm)
elec
 (type power)
 - electric log no
 (yes or no)
 (organization running log)
 - how well bottom plugged sandshark

RECEIVED


MAY 06 1993

Dept. of Environmental Quality
 Office of Land & Water Resources

DRILLERS REMARKS:

If well telescopes please sketch and show depths.

GROUND LEVEL

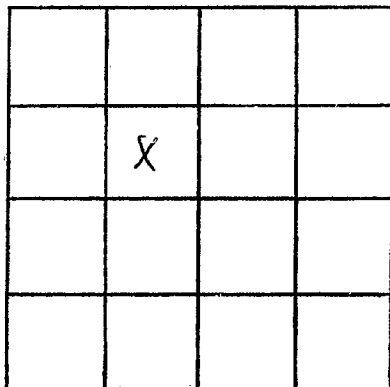

SECTION 17

Please indicate well location X.

ADDITIONAL INFORMATION

If more than one screen,
show locations of each on sketch.